

R 8985
78676

Form OR-010-7300-2
4/83

UNITED STATES
DEPARTMENT OF THE INTERIOR
BUREAU OF LAND MANAGEMENT

Section
21

Township 37S

Appl. No. R-67409


SESW

Range 23E

Permit No. R 8985

Will. Mer.

New Reservoir (#1463)

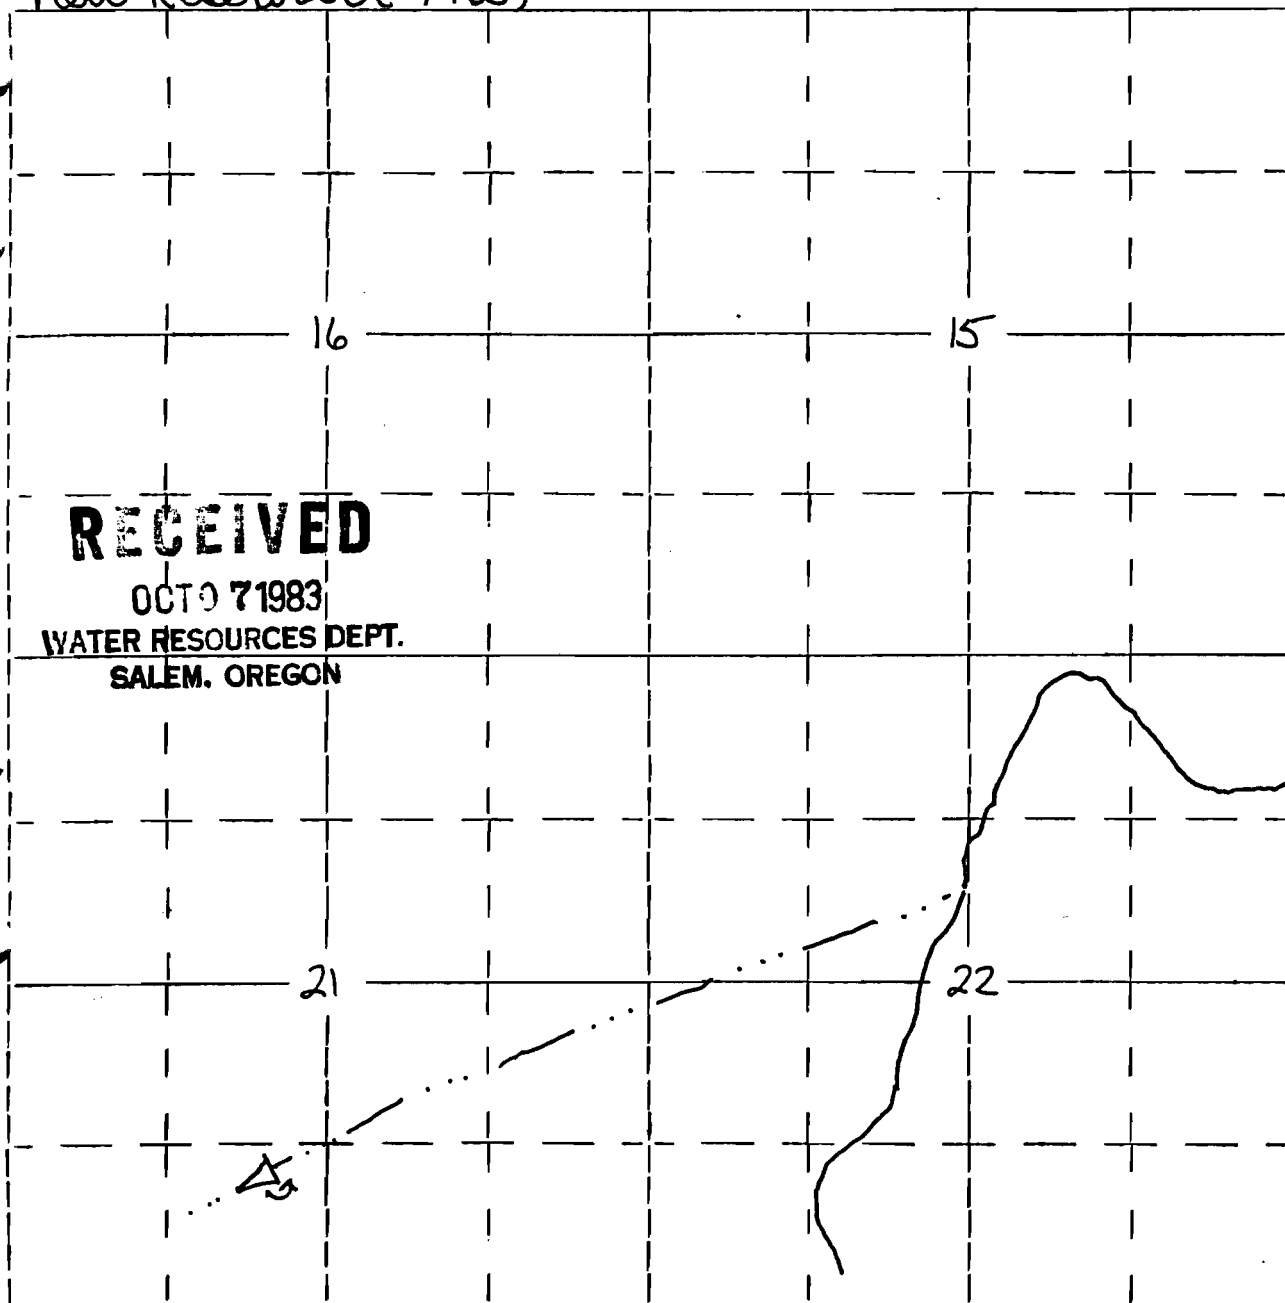

RECEIVED

OCT 7 1983

WATER RESOURCES DEPT.

SALEM, OREGON

1000' N, 2,200' E of SW corner of section 21