

R8987
78677

Form OR-010-7300-2
4/83

UNITED STATES
DEPARTMENT OF THE INTERIOR
BUREAU OF LAND MANAGEMENT

Section
36
NESW

Township 38 south


Range 23 east

Appl. No. R-67412

Permit No. R 8987

Will. Mer.

Blue Res. (#1051)

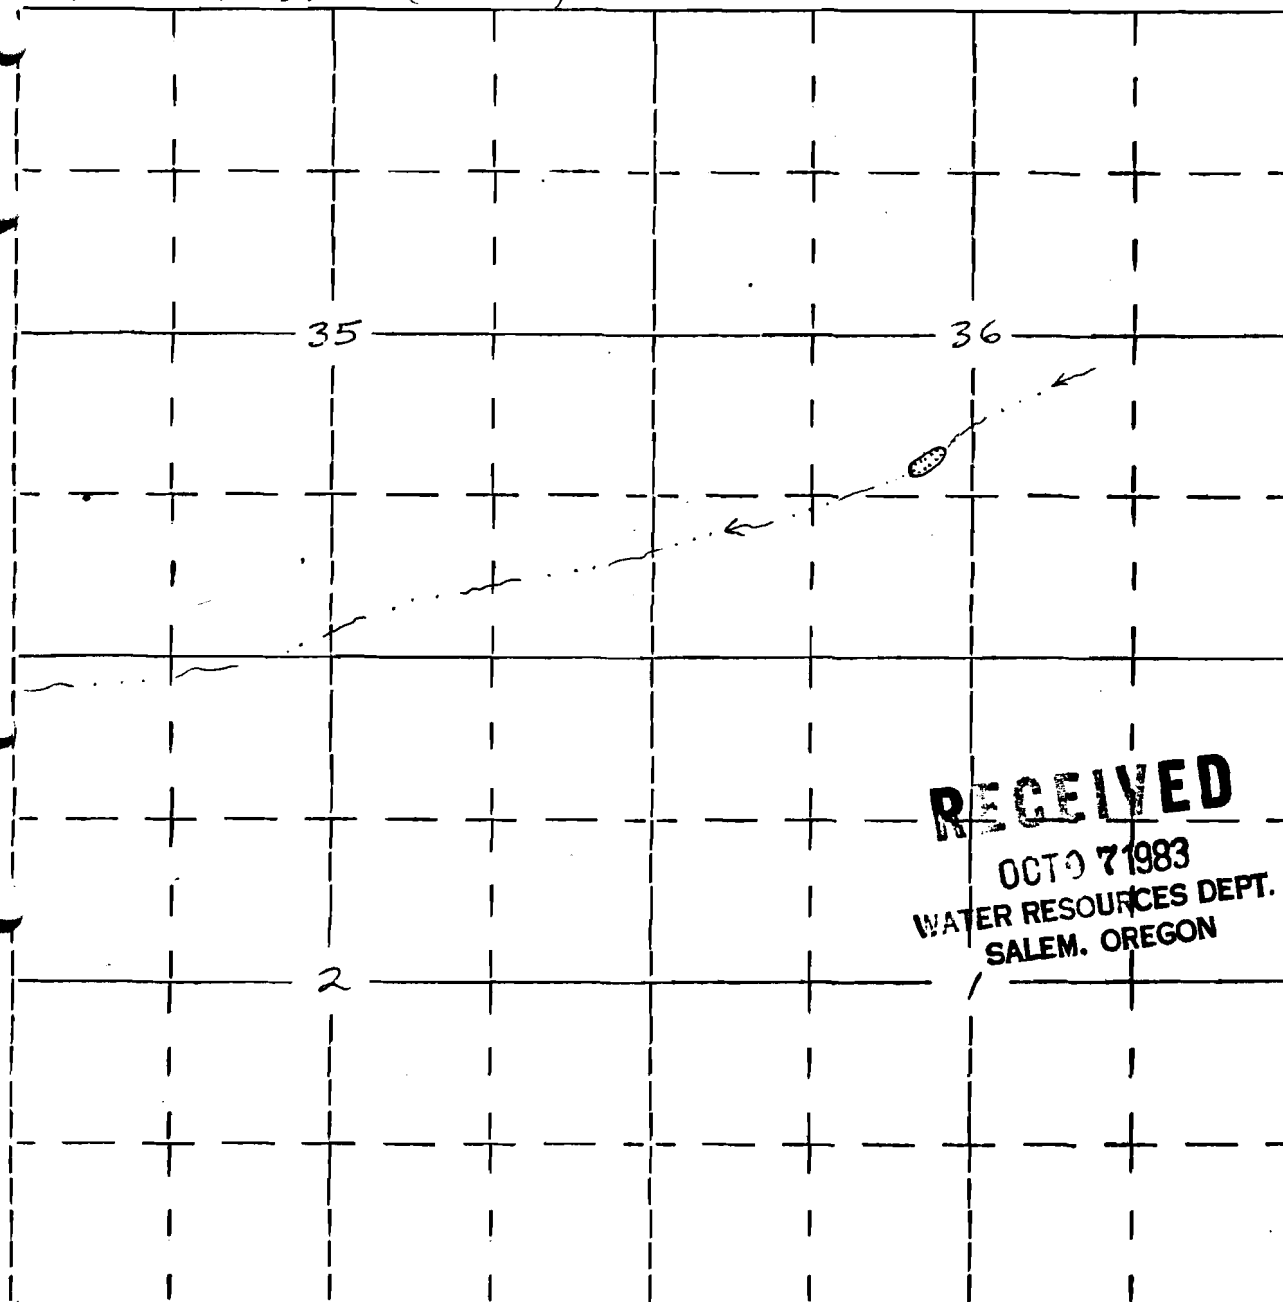

RECEIVED
OCT 9 7 1983
WATER RESOURCES DEPT.
SALEM, OREGON

1360' N., 2320 E. of SW Corner of Section 36