

R 8989
78678

Form OR-010-7300-2
4/83

UNITED STATES
DEPARTMENT OF THE INTERIOR
BUREAU OF LAND MANAGEMENT


Section
9
NWSE

Township 35 South
Range 22 East

Appl. No. R-67414
Permit No. R 8989

Will. Mer.

Foreward Reservoir (#4843)

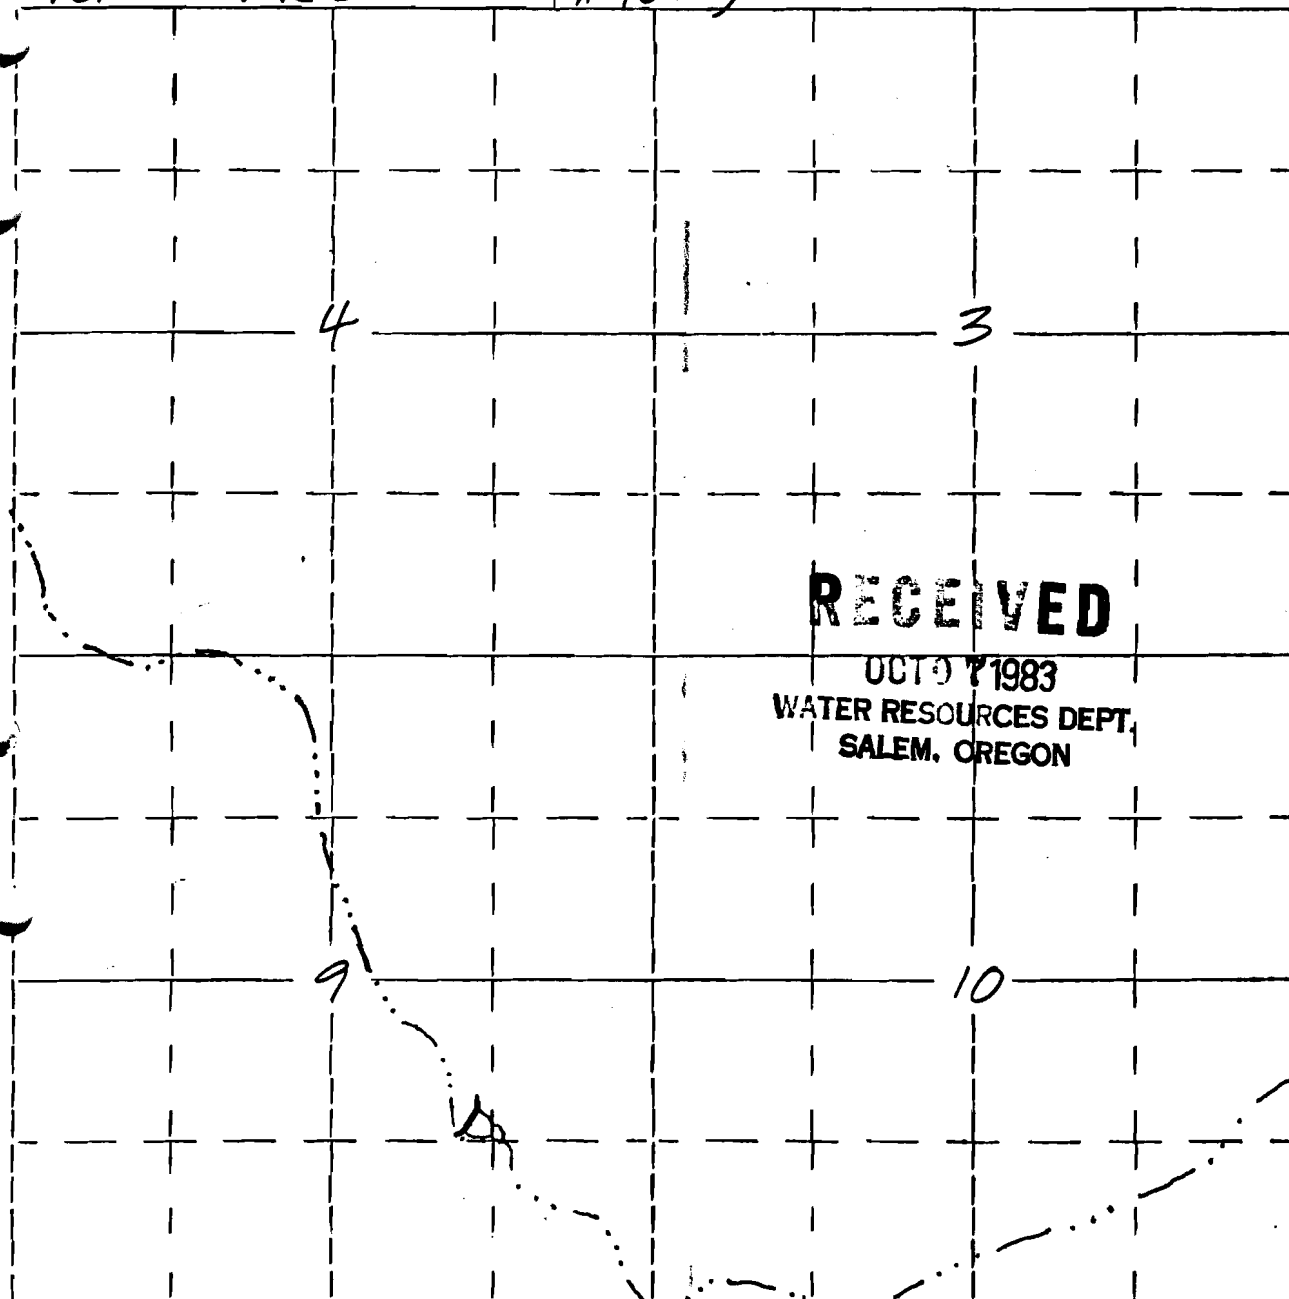

RECEIVED

OCT 9 1983
WATER RESOURCES DEPT.
SALEM, OREGON

1410' N, 1390' W of SE Corner of Section 9