

9-81

UNITED STATES
DEPARTMENT OF THE INTERIOR
BUREAU OF LAND MANAGEMENT

SECTION


31

Oregon State Water Filings

TOWNSHIP 39S, RANGE 27E, W. M.

NENE

North

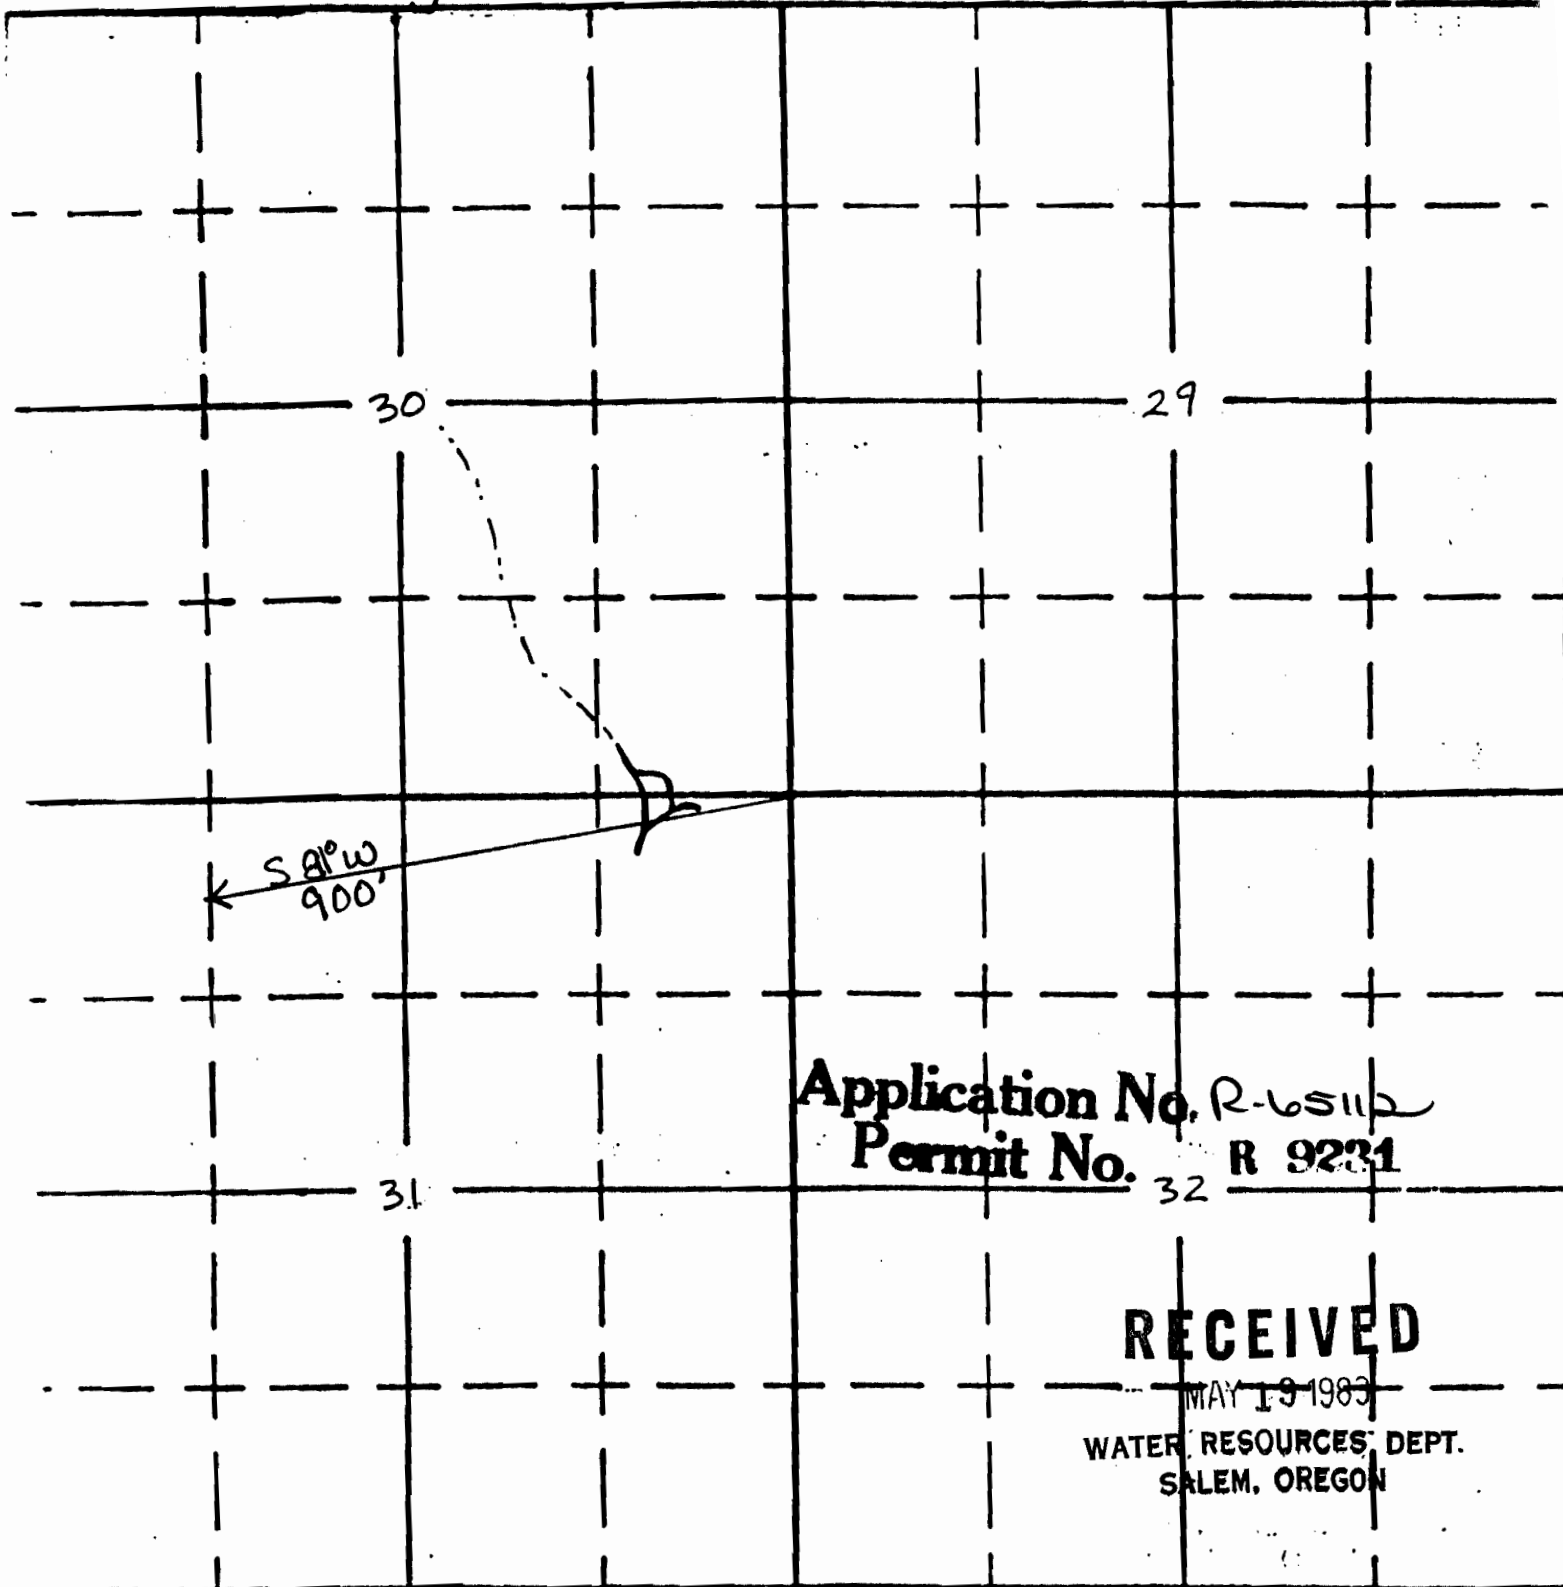

Application No. R-65112
Permit No. R 9231

RECEIVED

MAY 19 1983

WATER RESOURCES DEPT.
SALEM, OREGON

South

APPLICATION No.

PERMIT No.