

SECTION

8

Oregon State Water Filings


R9236

78681

TOWNSHIP 39S, RANGE 24E, W. M.

NW 1/4

North

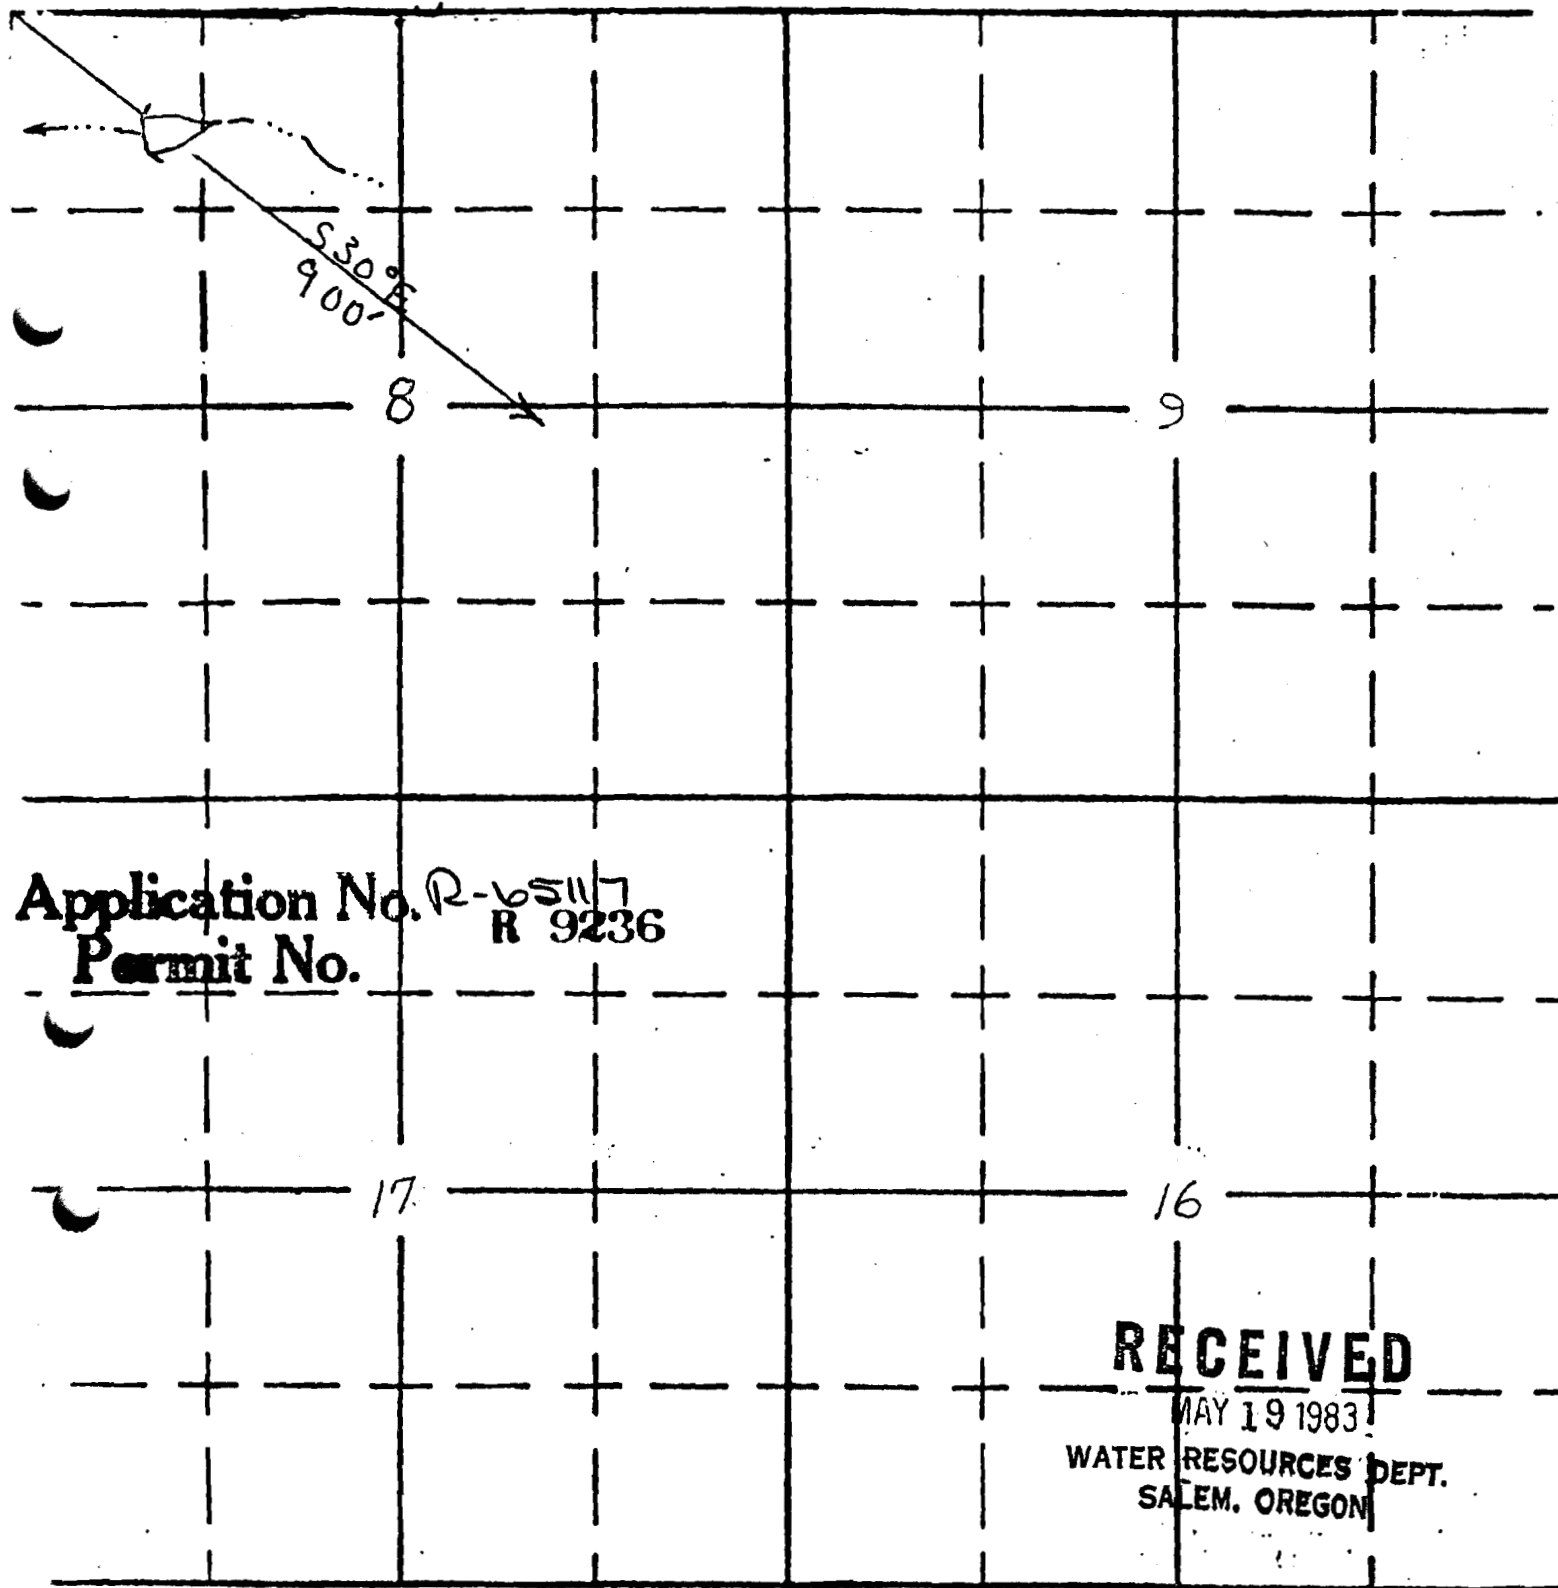

South

APPLICATION No.
PERMIT No.