

SECTION


18

# Oregon State Water Filings

TOWNSHIP 39S, RANGE 28E, W. M.

SE NW

North

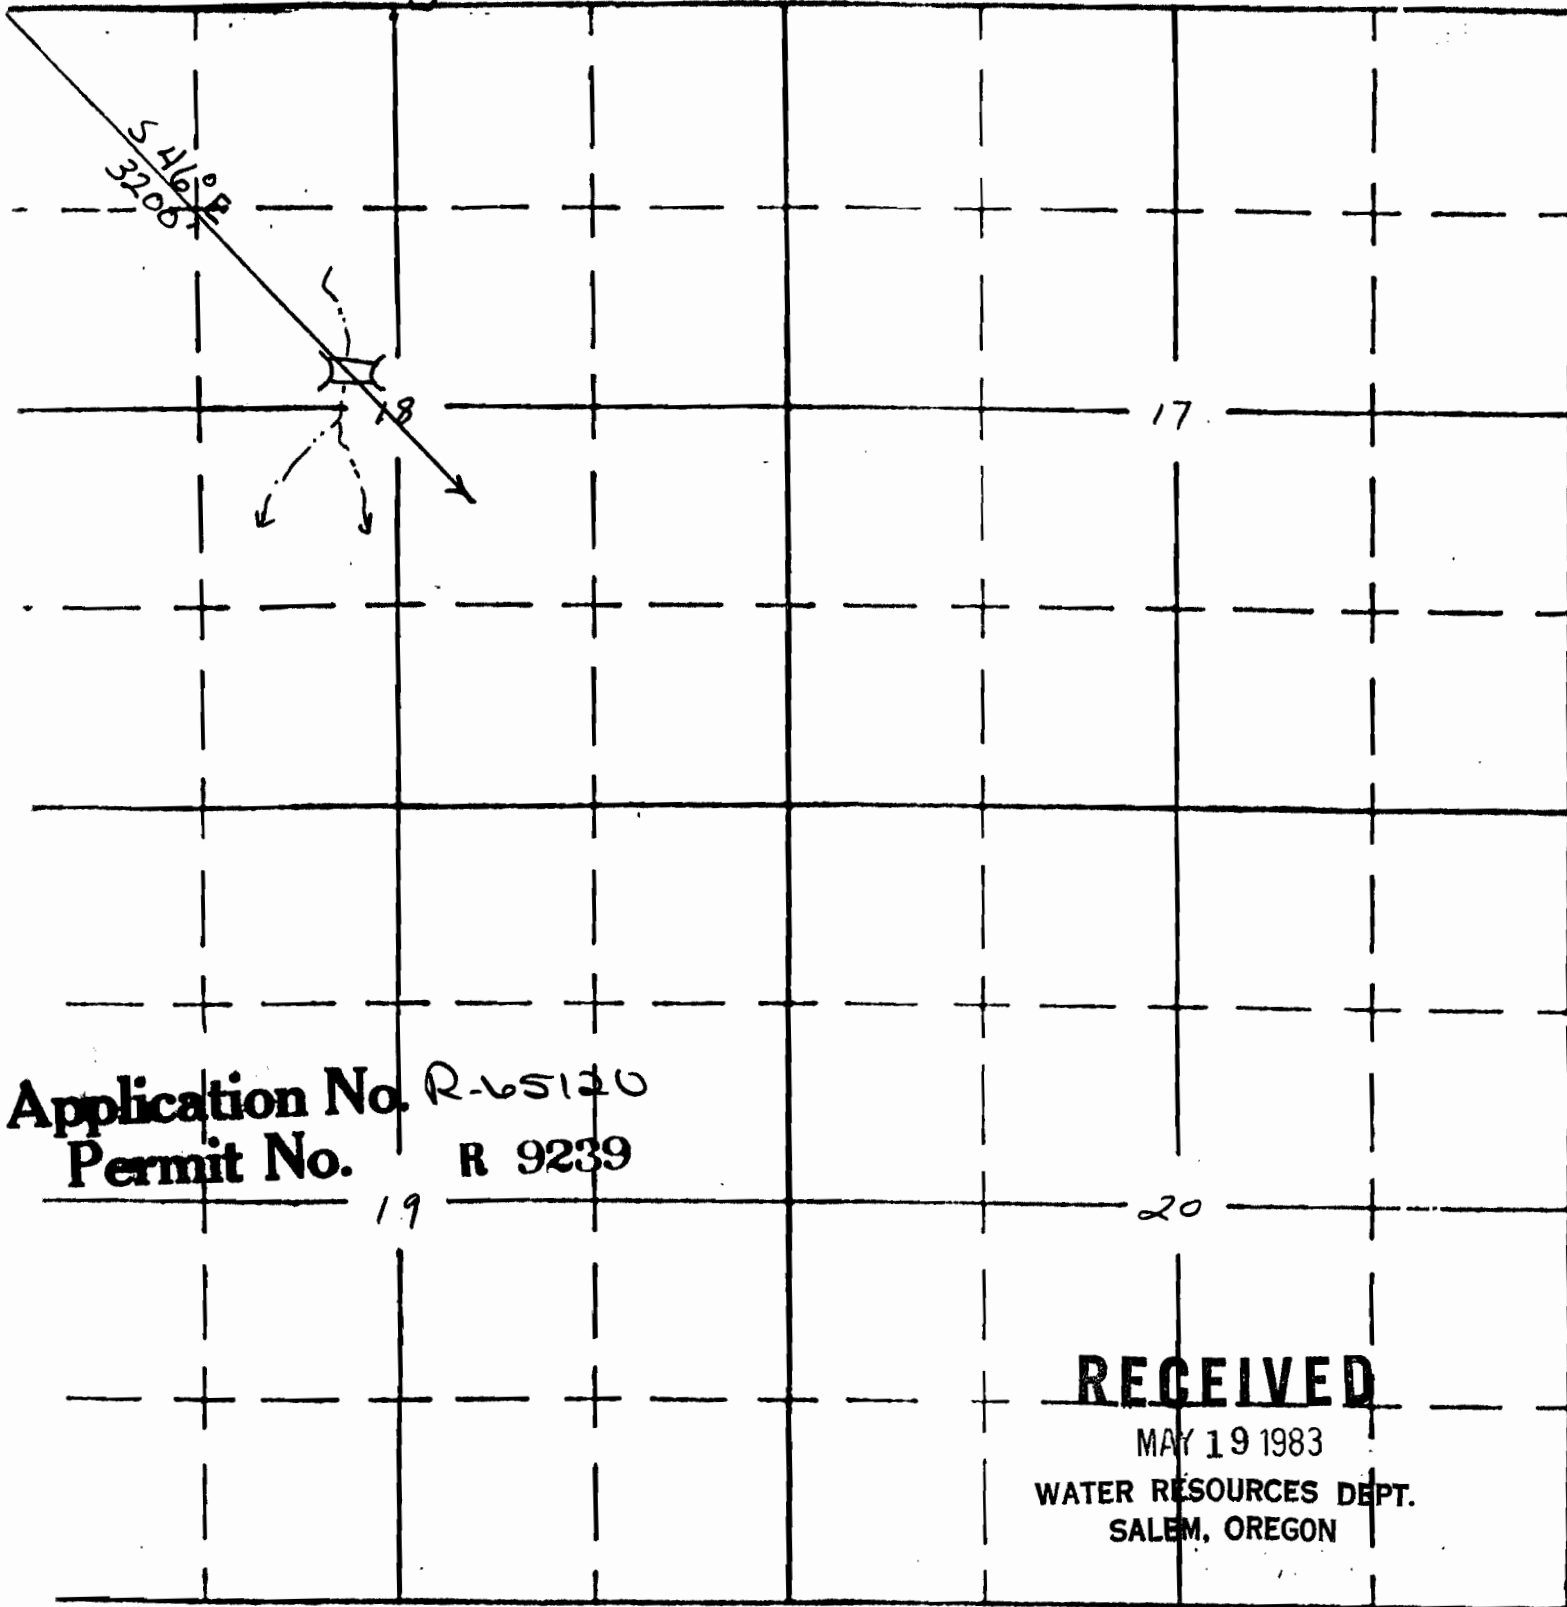

Application No. R-65120  
Permit No. R 9239

19

20

**RECEIVED**

MAY 19 1983

WATER RESOURCES DEPT.  
SALEM, OREGON

South

APPLICATION No.

PERMIT No.