

SECTION

3

Oregon State Water Filings


TOWNSHIP 40 S, RANGE 22 E, W. M.

SE SW

North

Basin

1139

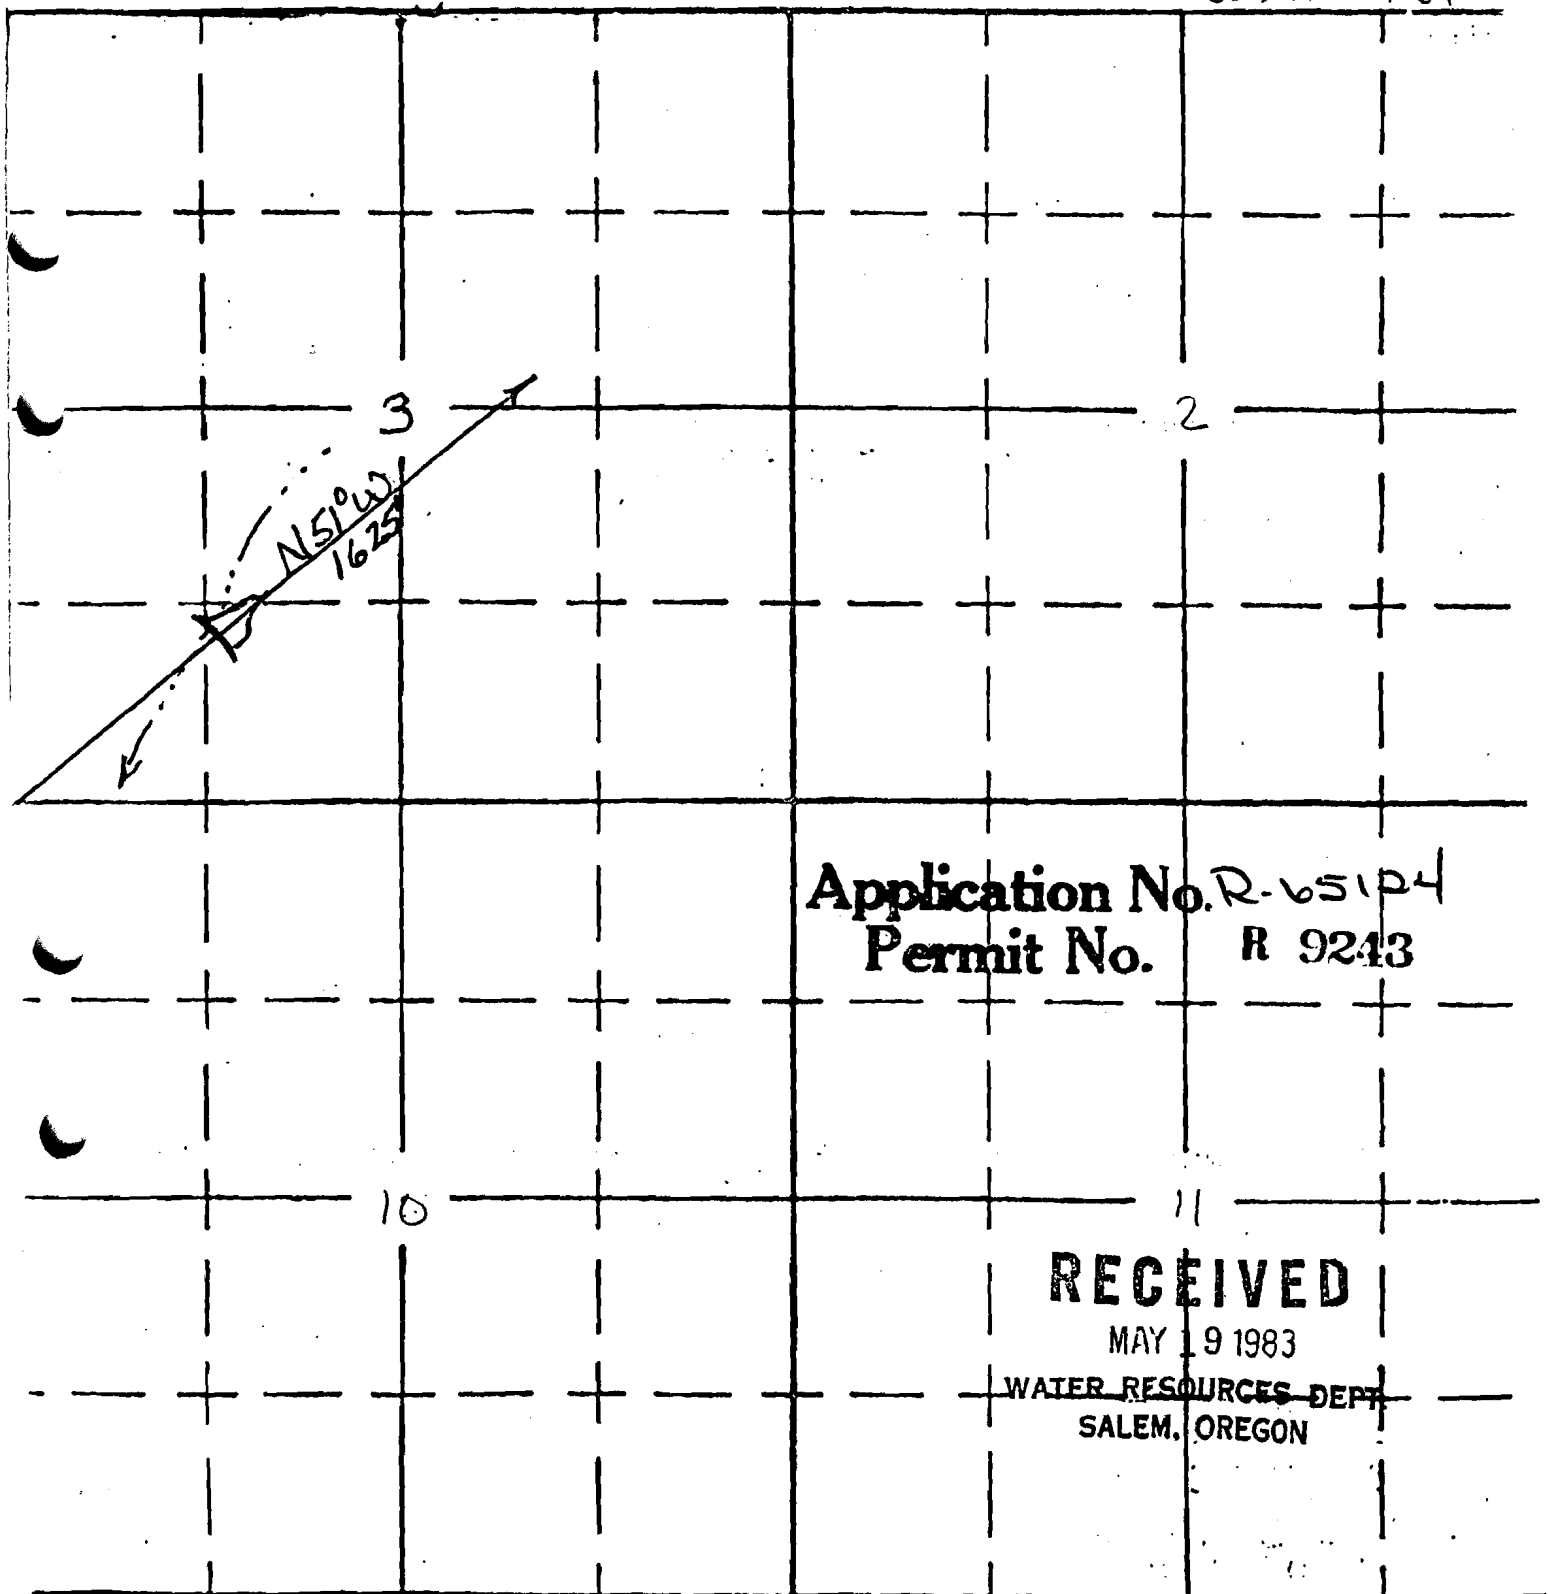

Application No. R-65124
Permit No. R 9243

RECEIVED

MAY 19 1983

WATER RESOURCES DEPT.
SALEM, OREGON

South

APPLICATION No.