

Form OR-010-7300-2
4/83

UNITED STATES
DEPARTMENT OF THE INTERIOR
BUREAU OF LAND MANAGEMENT

Section

21

Township

31 S

Appl. No.

R67598

SESE

Range


28 E

Permit No.

R 9463

Will. Mer.

Central Dugout #1 1296

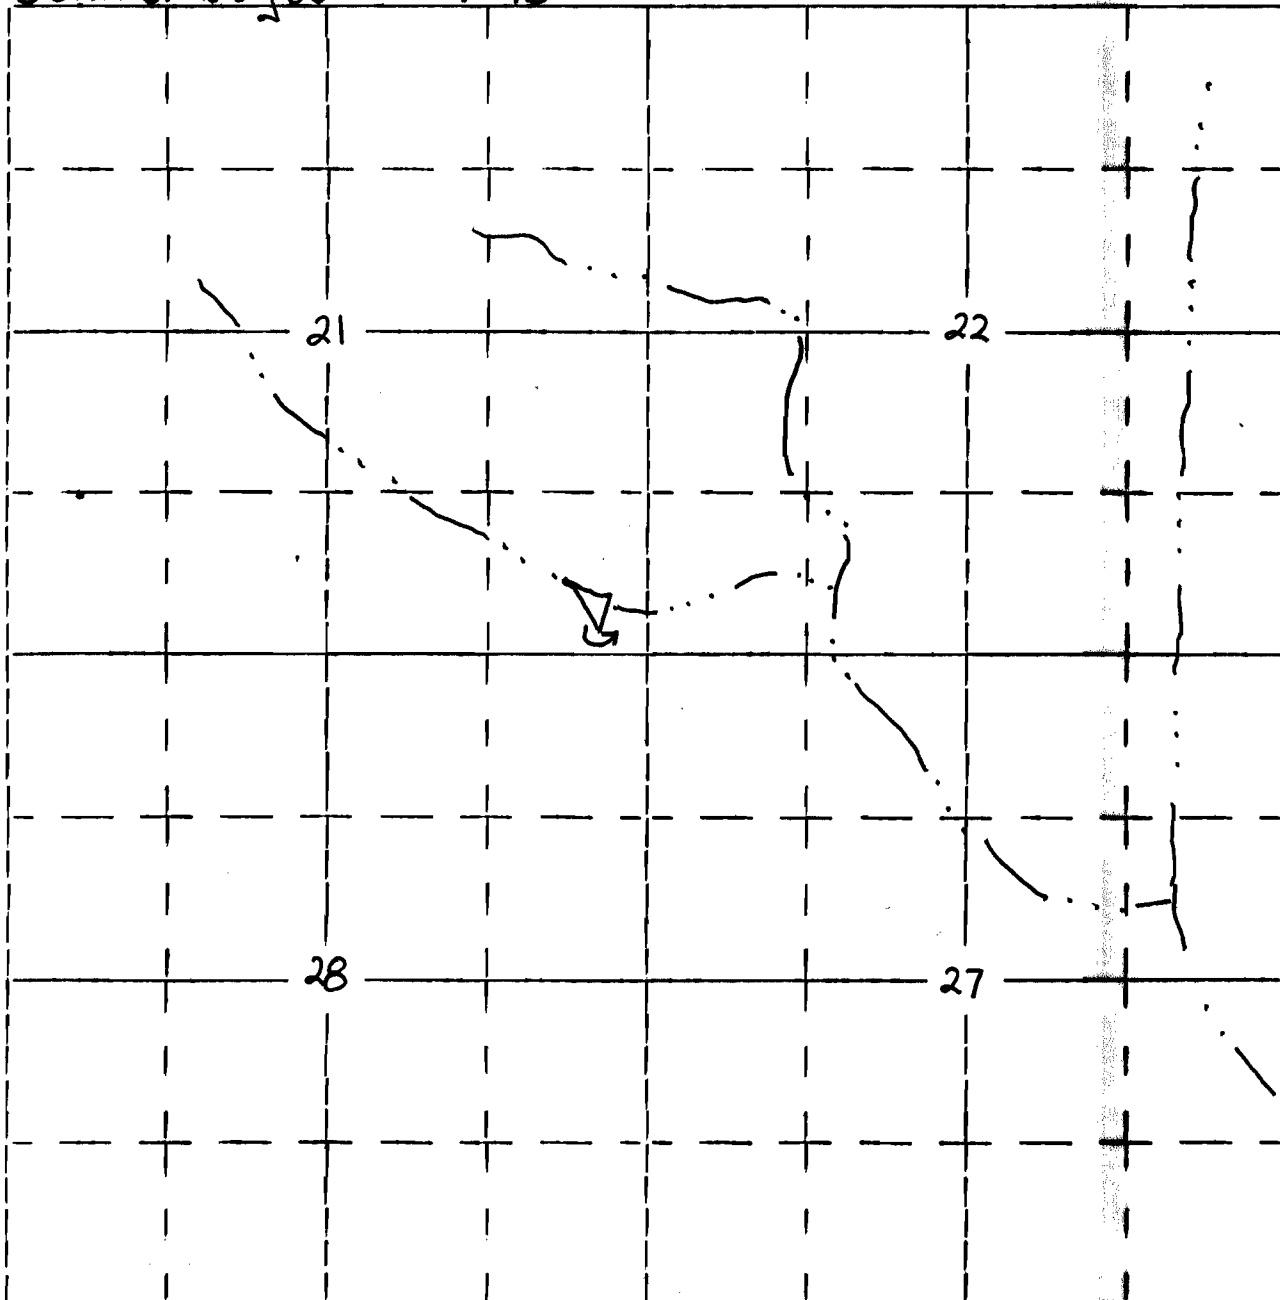

350' N 300' W of the SE corner of section 21