

Form OR-010-7300-2
4/83

UNITED STATES
DEPARTMENT OF THE INTERIOR
BUREAU OF LAND MANAGEMENT


Section
15

Township 30 south
Range 28 east

Appl. No. **R67599**

Permit No. **R 9464**

North Loggerhead Res. (#1329)

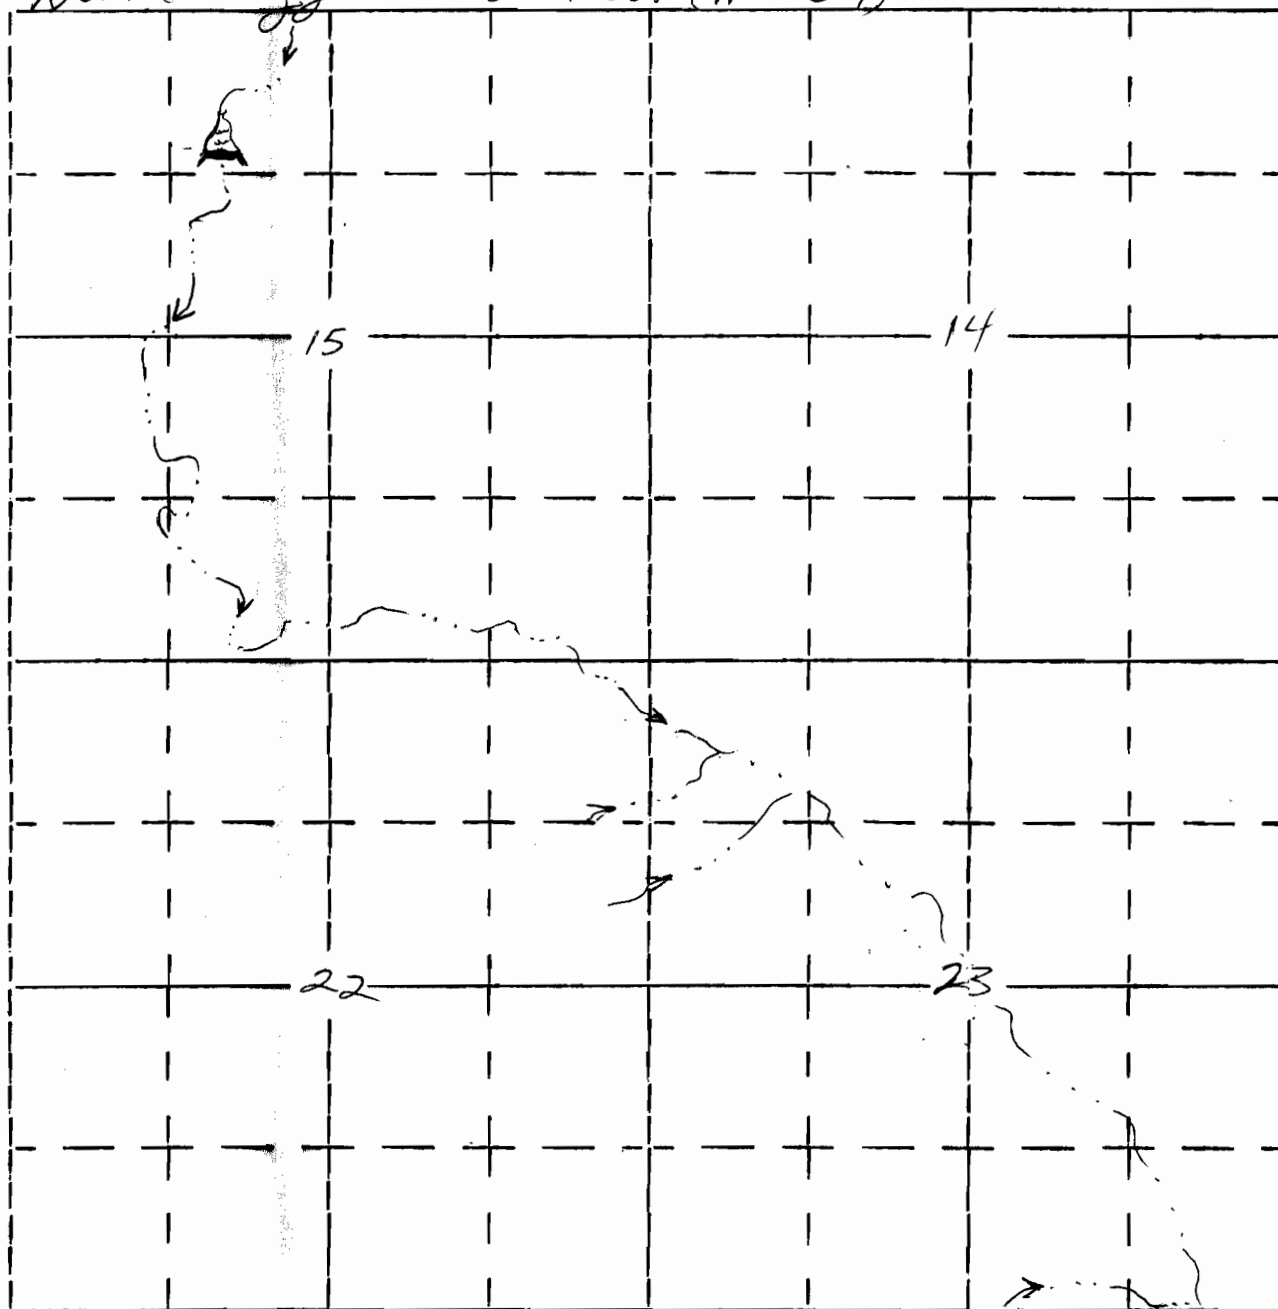

1190' S., 1715 E. of NW corner, section 15