

R9467
78686

Form OR-010-7300-2
4/83


UNITED STATES
DEPARTMENT OF THE INTERIOR
BUREAU OF LAND MANAGEMENT

Section
27
SENE

Township 30 south
Range 27 east

Appl. No. R67603
Permit No. R 9467

Open Draw Reservoir (1466)

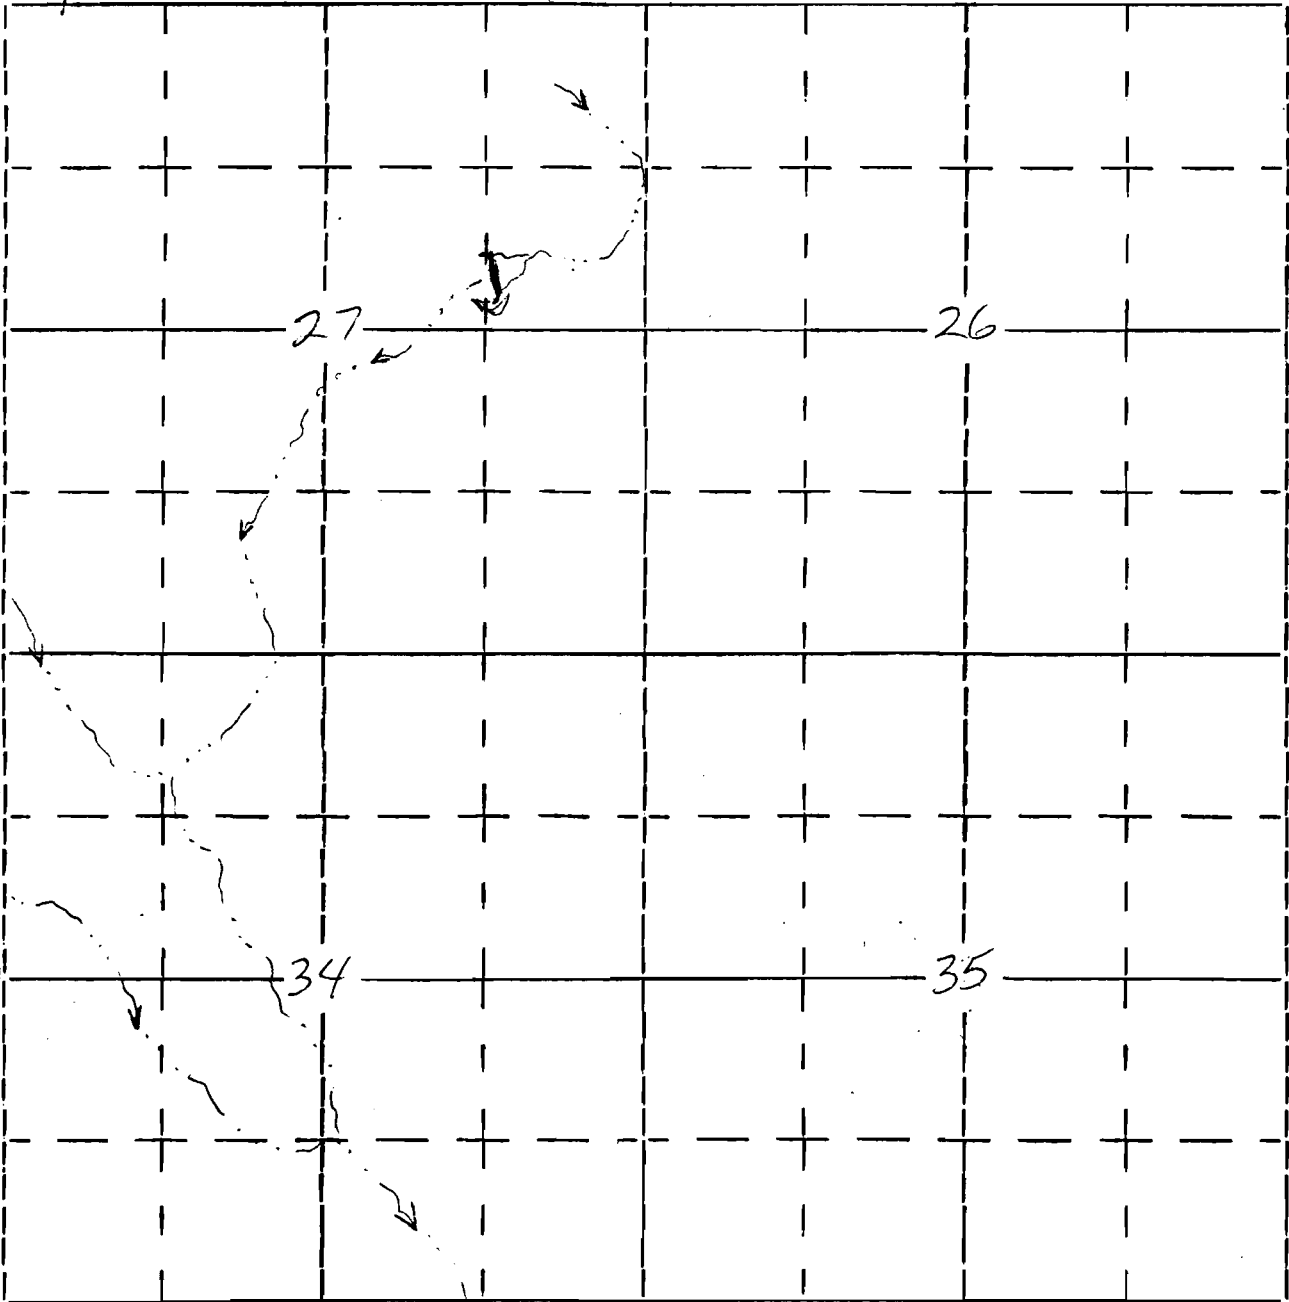

2215 S., 1265' W. of NE Corner, section 27

15002