

Form OR-010-7300-2
4/83

UNITED STATES
DEPARTMENT OF THE INTERIOR
BUREAU OF LAND MANAGEMENT


Section 5
NW NE

Township 38S
Range 23E

Appl. No. **R67604**
Permit No. **R 9468**

Will. Mer.

End of Day Reservoir 1419

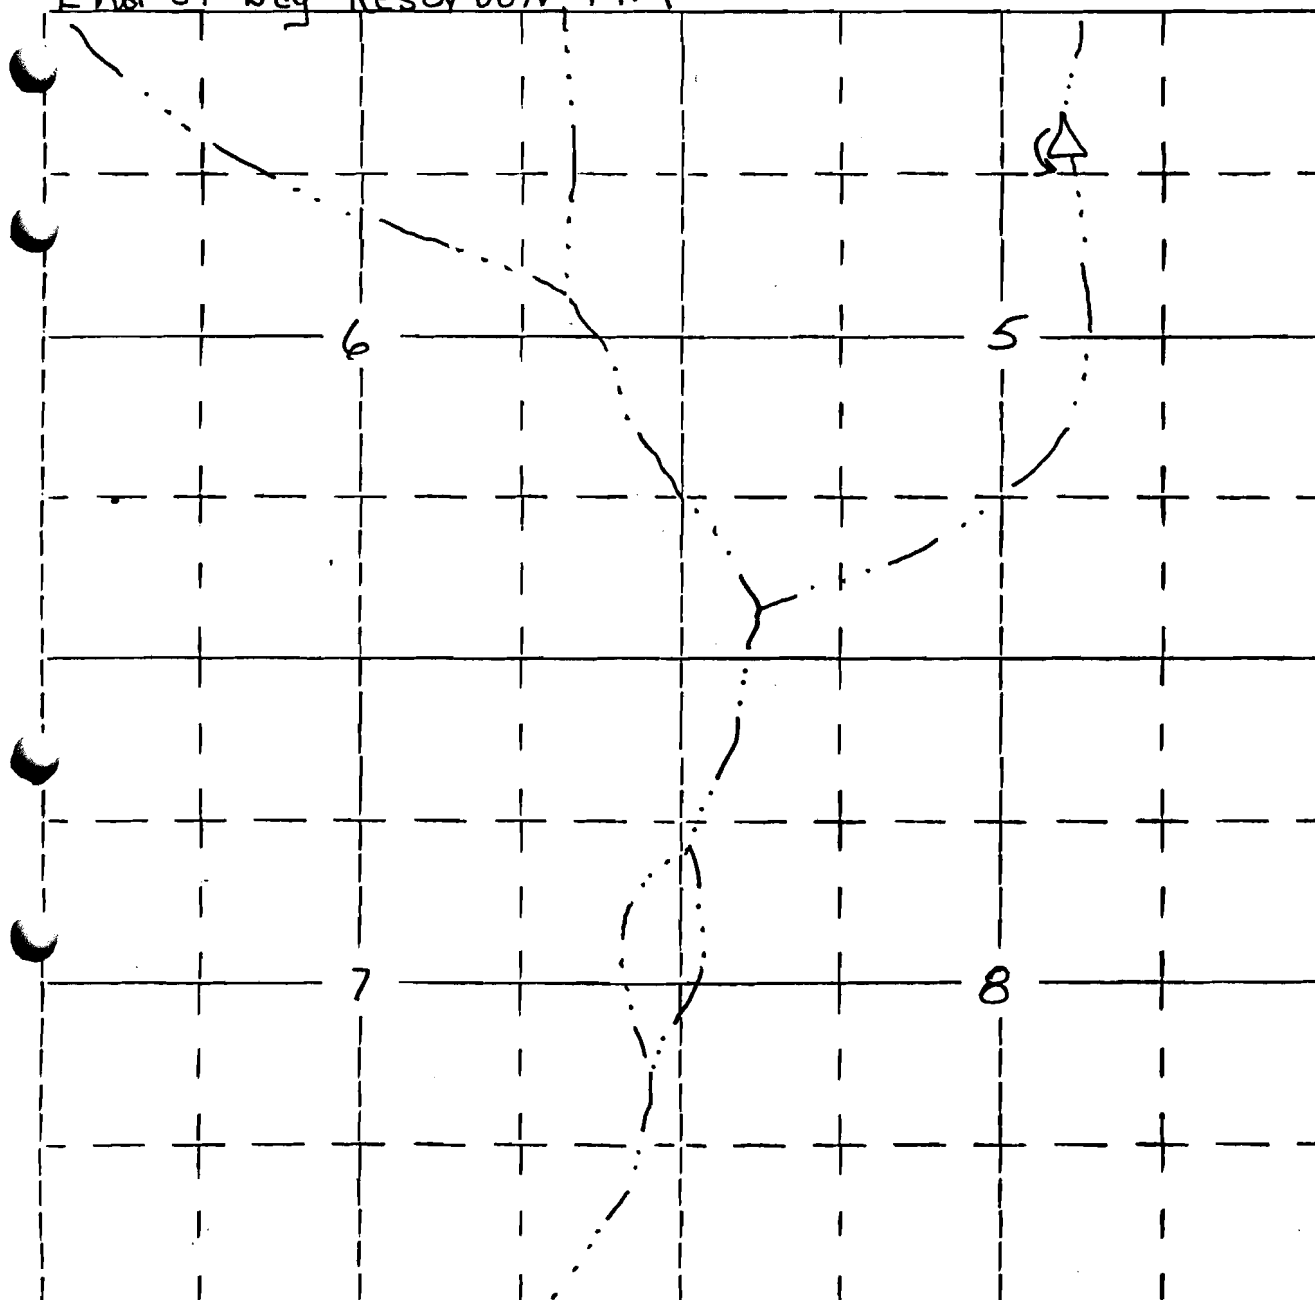

1200'S 2200'W of the NE corner of section 5