

Form OR-010-7300-2
4/83

UNITED STATES
DEPARTMENT OF THE INTERIOR
BUREAU OF LAND MANAGEMENT

Section

11

Township 30S

Appl. No. **R67606**


NENE

Range 28E

Permit No. **R 9470**

Will. Mer.

Fleece Reservoir #1503

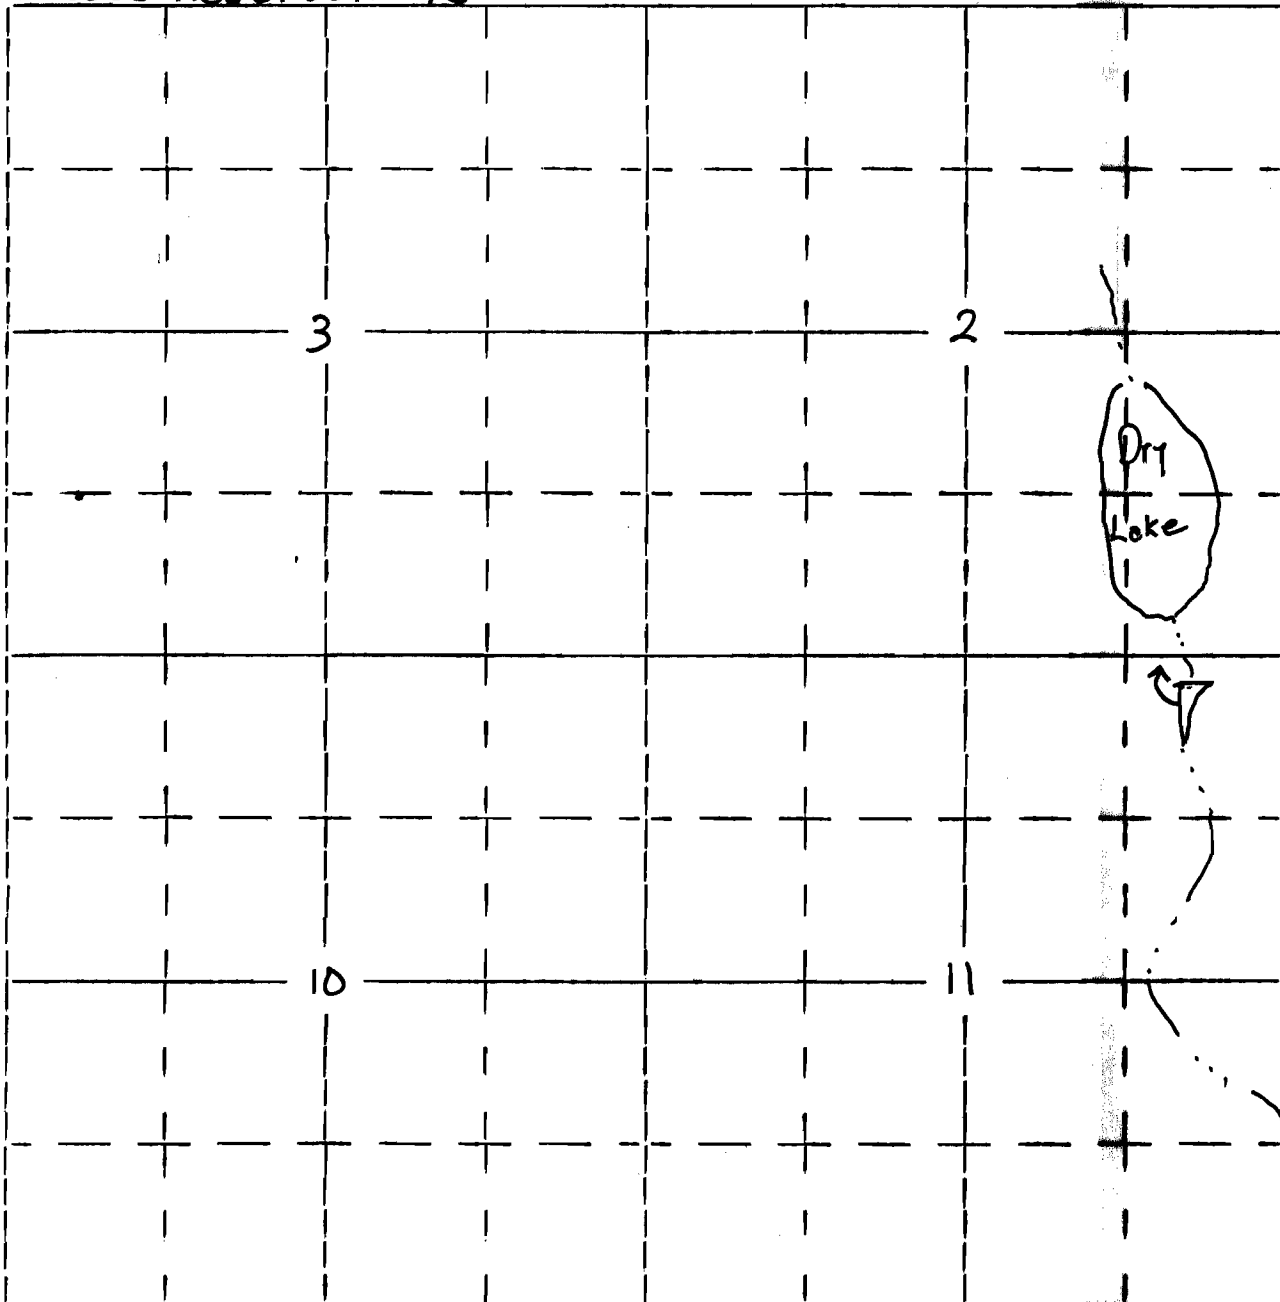

200'S 700'W of the NE Corner of section 11