

Form OR-010-7300-2
4/83

UNITED STATES
DEPARTMENT OF THE INTERIOR
BUREAU OF LAND MANAGEMENT

Section 9
SWNW

Township 32 S


Range 24E

Appl. No. **R67607**

Permit No. **R 9471**

Will. Mer.

Three Forks W.H. (3581)

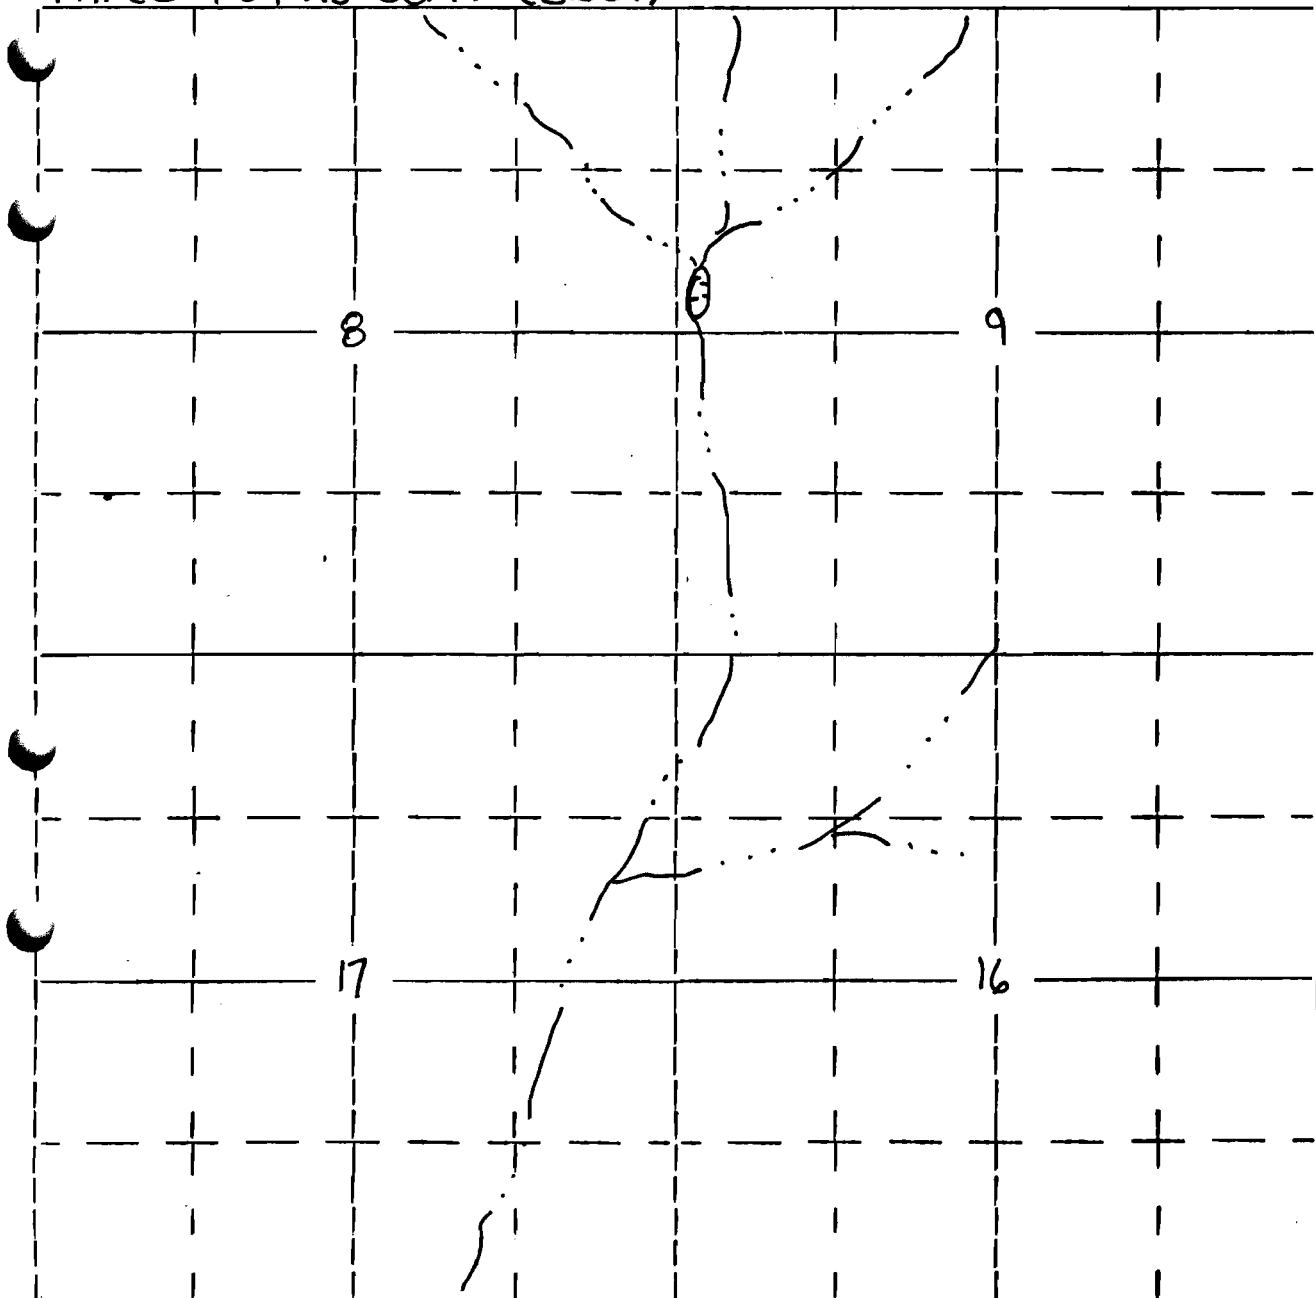

2200'S 300'E of the NW corner of Section 9