

R9473
78691

Form OR-010-7300-2
4/83

UNITED STATES
DEPARTMENT OF THE INTERIOR
BUREAU OF LAND MANAGEMENT


Section 7
SENE

Township 39S
Range 24E

Appl. No. R67609
Permit No. R 9473

Will. Mer.

Salem and W.H #0967

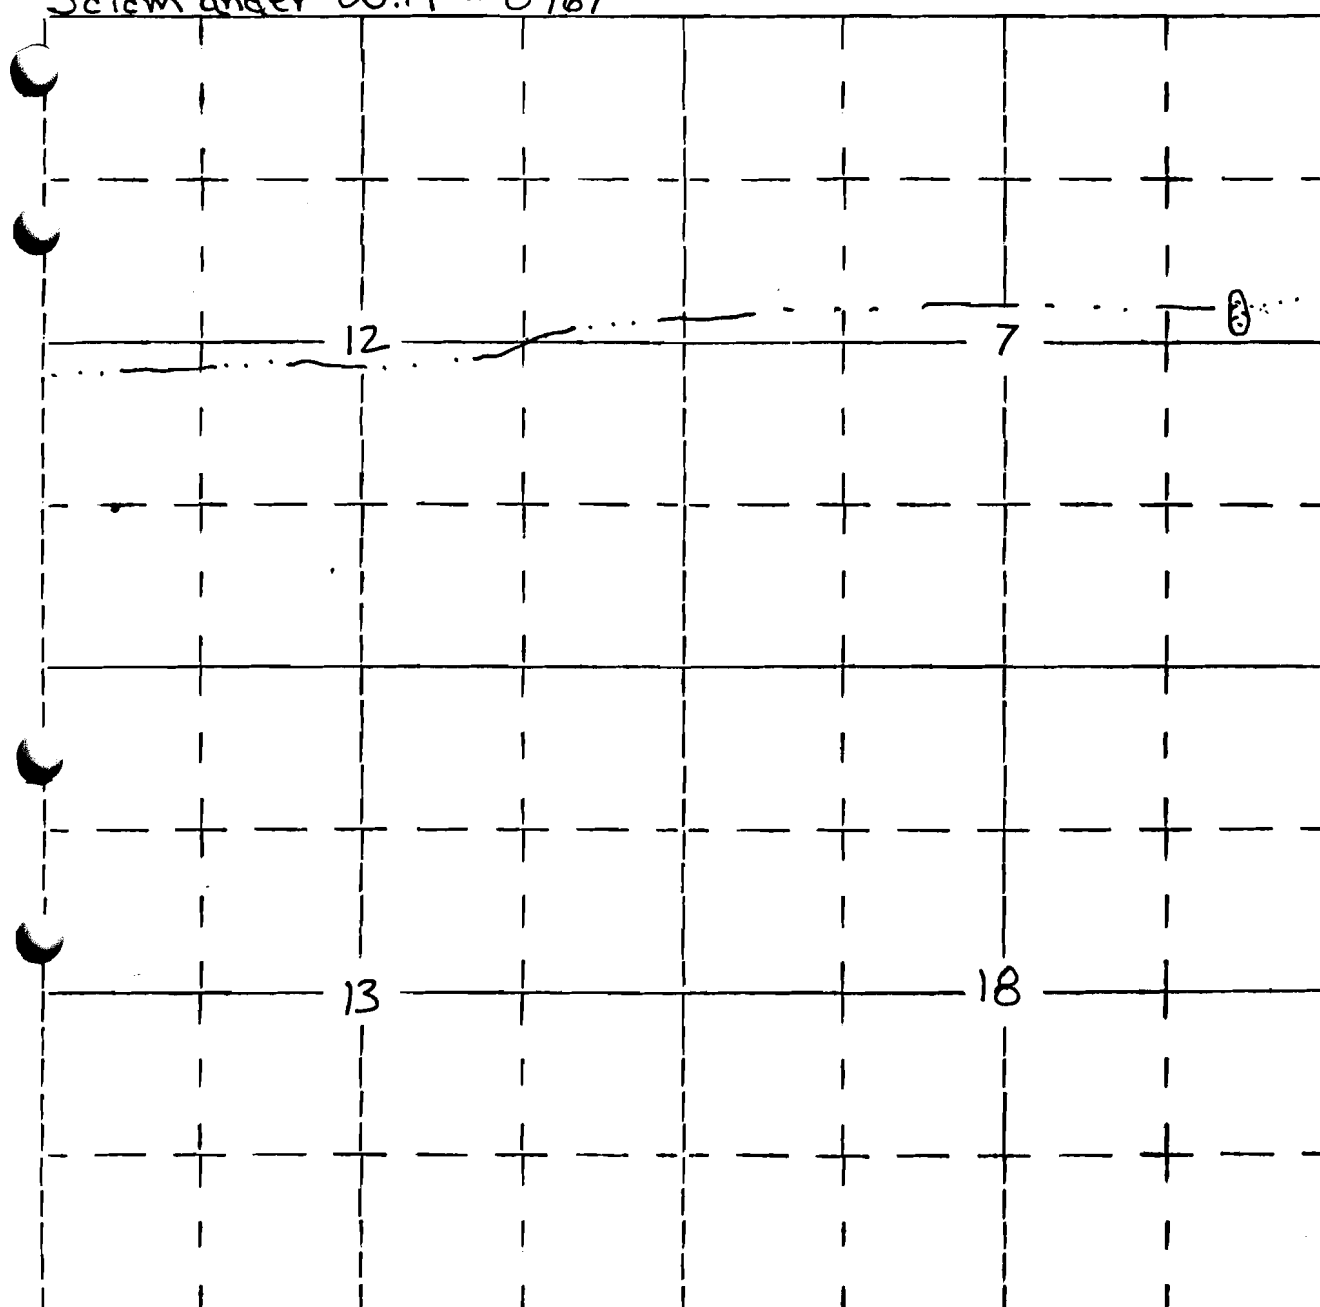

2300'S 1,200'W of the NE corner of Section 7