

Form OR-010-7300-2
4/83

UNITED STATES
DEPARTMENT OF THE INTERIOR
BUREAU OF LAND MANAGEMENT

Section

Township 39S


Appl. No. **R67610**

Range 23E

Permit No. **R 9474**

Will. Mer.

Noon Reservoir 0977

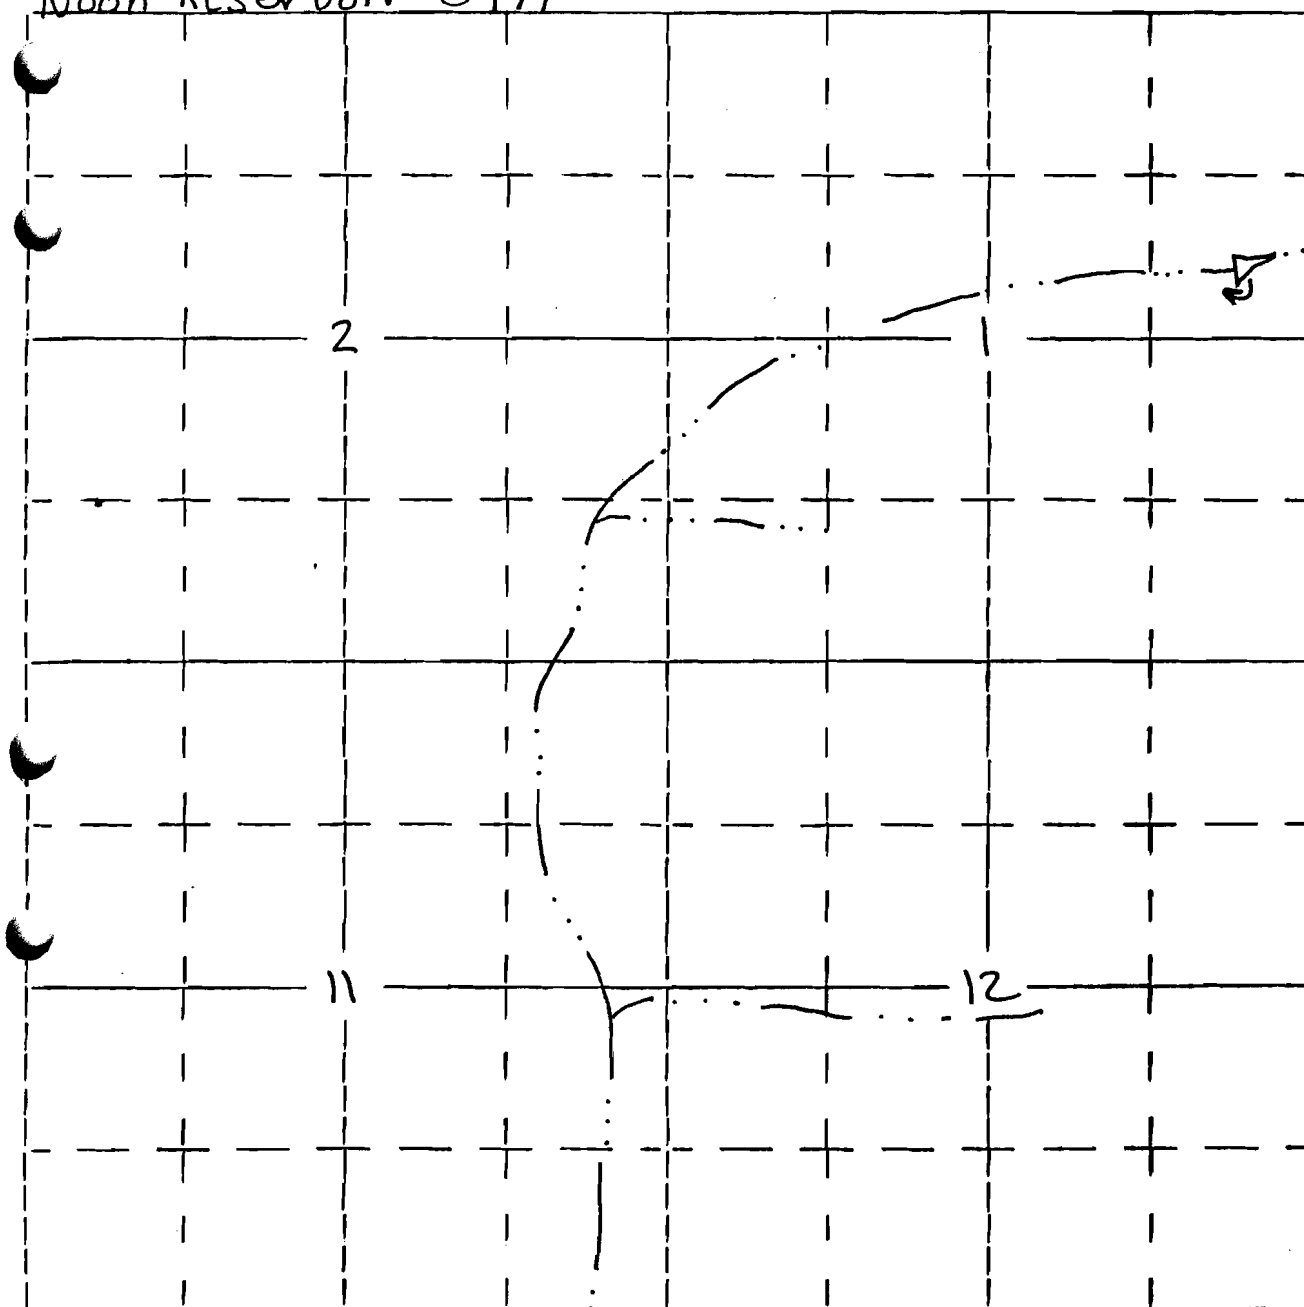

1600's 550' W of the NE corner of section 1