

R9485  
78694

Form OR-010-7300-2  
4/83

UNITED STATES  
DEPARTMENT OF THE INTERIOR  
BUREAU OF LAND MANAGEMENT

Section


21

SESW

Township 31 south  
Range 27 east

Appl. No. R62622  
Permit No. R 9485

Mule Waterhole (#5134)

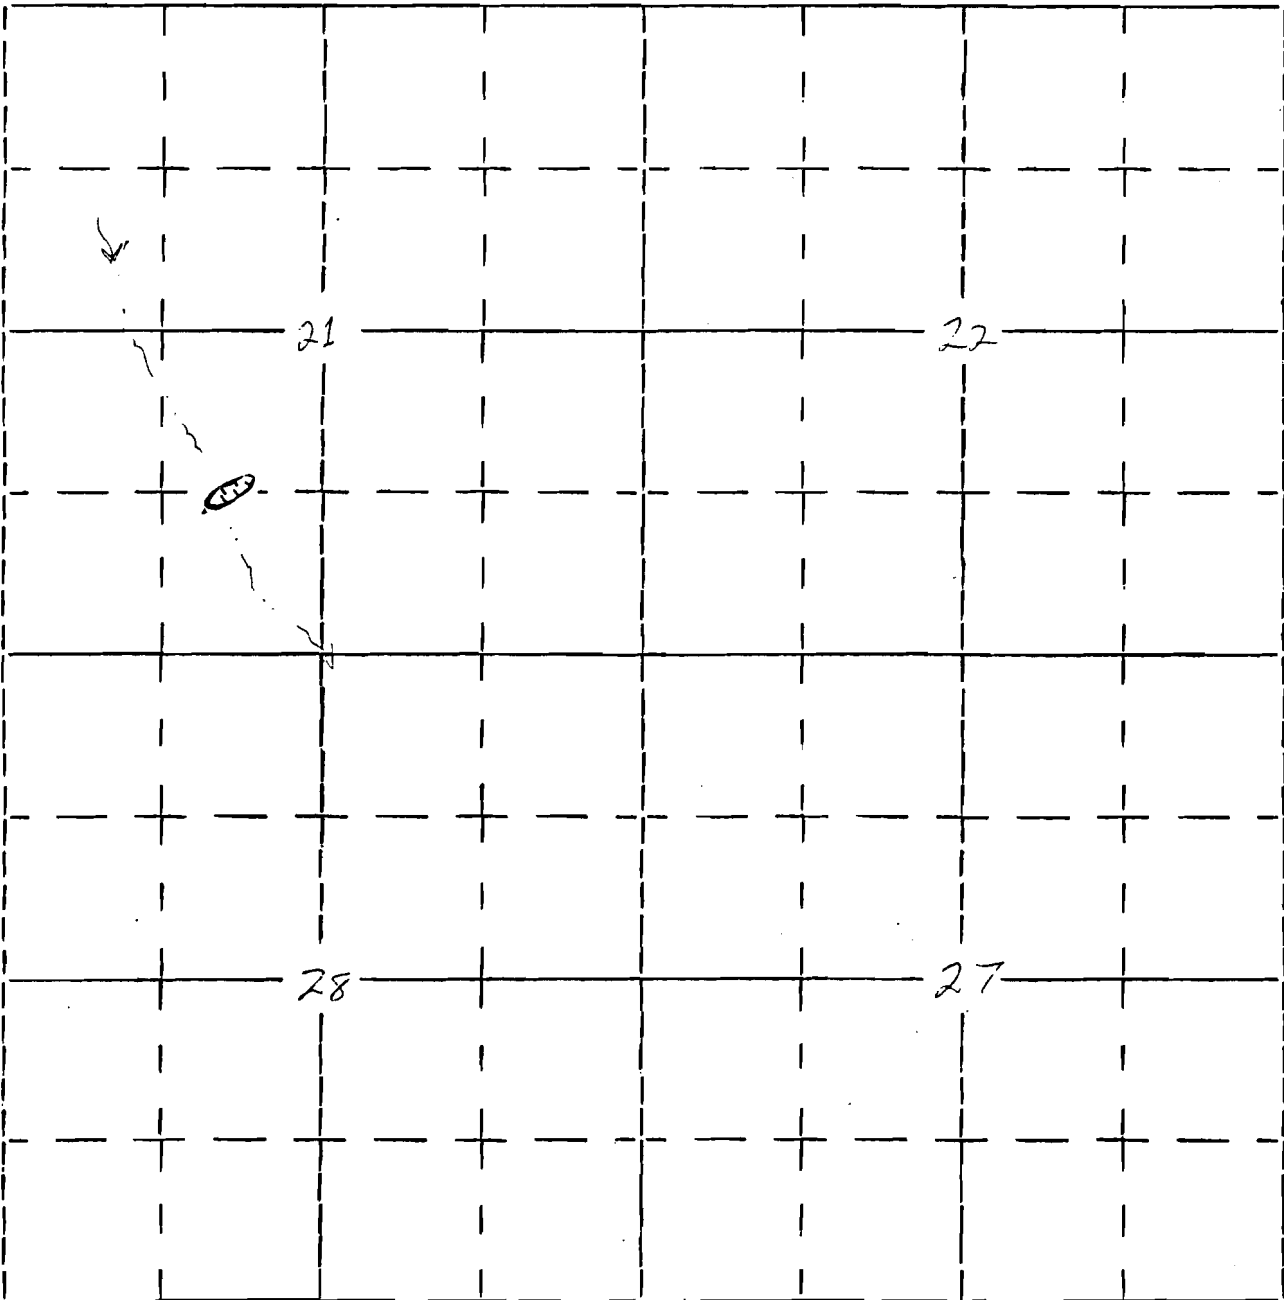

1300' N., 1910' E. of SW corner, section 21

1/1/83