

R9495
78695

Form OR-010-7300-2
4/83

UNITED STATES
DEPARTMENT OF THE INTERIOR
BUREAU OF LAND MANAGEMENT

Section 3

Township 28 S.

Appl. No. R67633


NE 1/4 SW 1/4

Range 25 E.

Permit No. R 9495

4 INCHES = 1 MILE

Will. Mer.

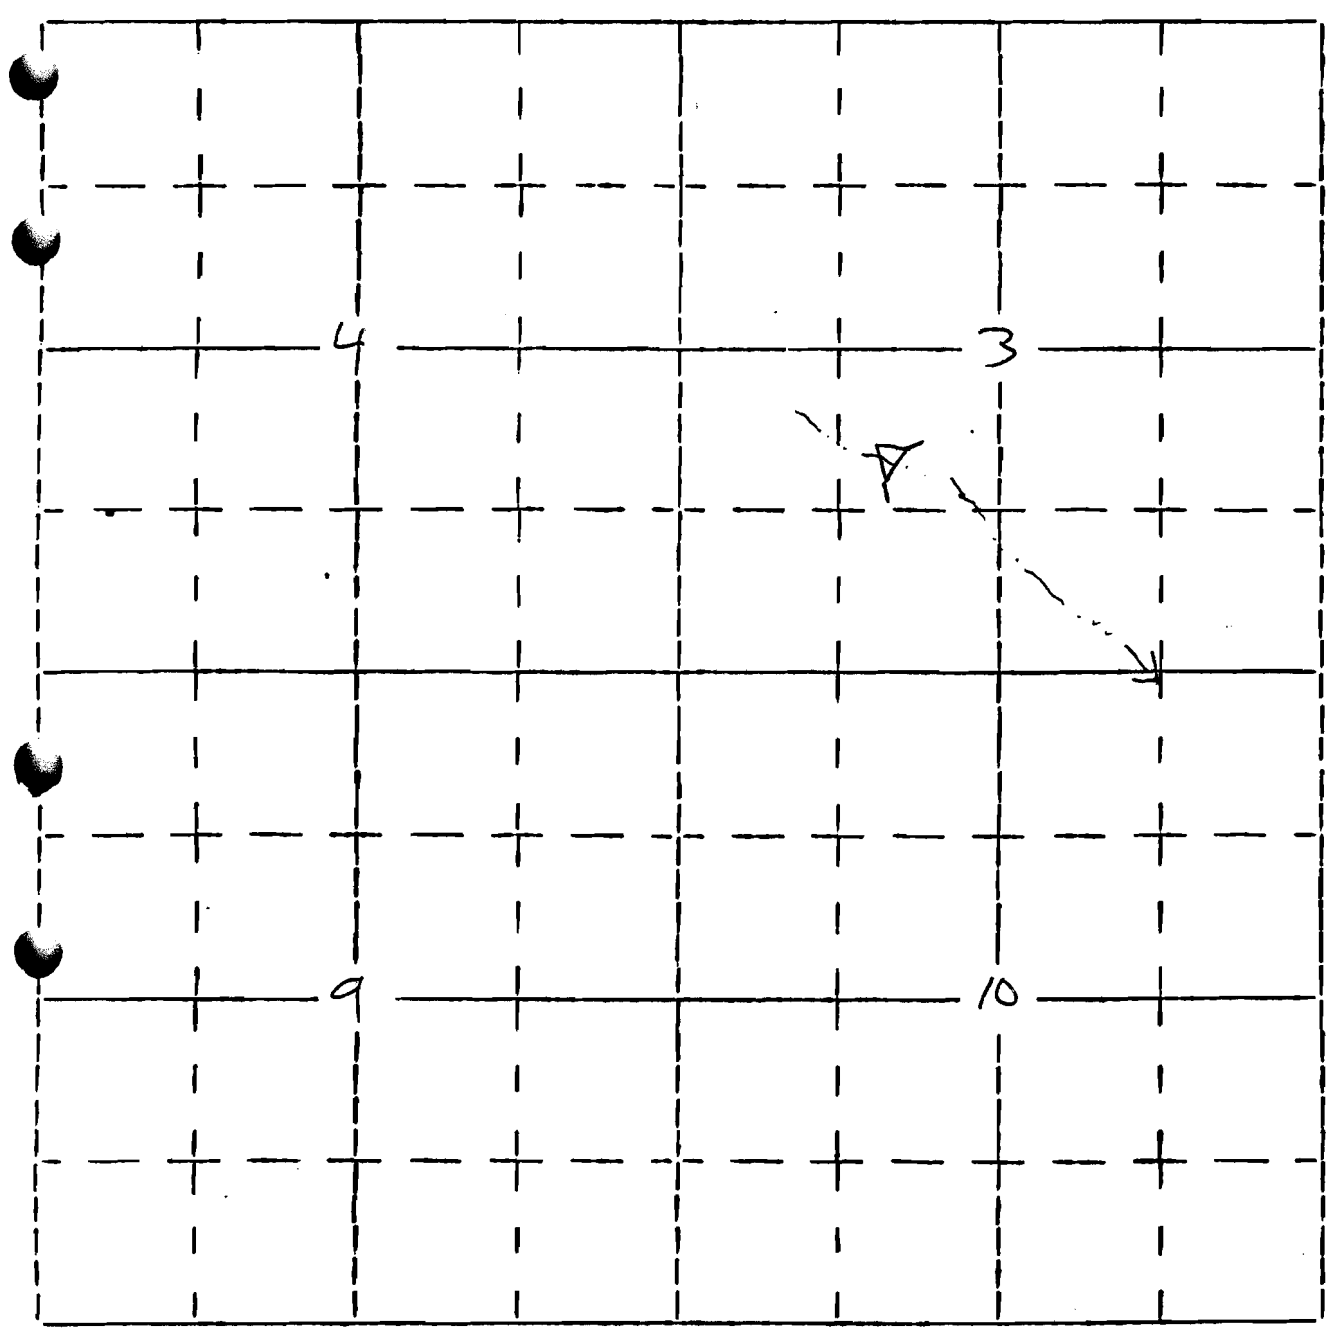

SPRING CANYON RESERVOIR # OR-010-R-4237
LOCATED 1,400 FEET NORTH AND 1,350 FEET
EAST OF THE SOUTHWEST CORNER OF SEC. 3.