

R9497
78696

Form OR-010-7300-2
4/83

UNITED STATES
DEPARTMENT OF THE INTERIOR
BUREAU OF LAND MANAGEMENT


Section 10
NESW

Township 28S
Range 25E

Appl. No. R67635
Permit No. R 9497

Will. Mer.

Contractor Reservoir 4236

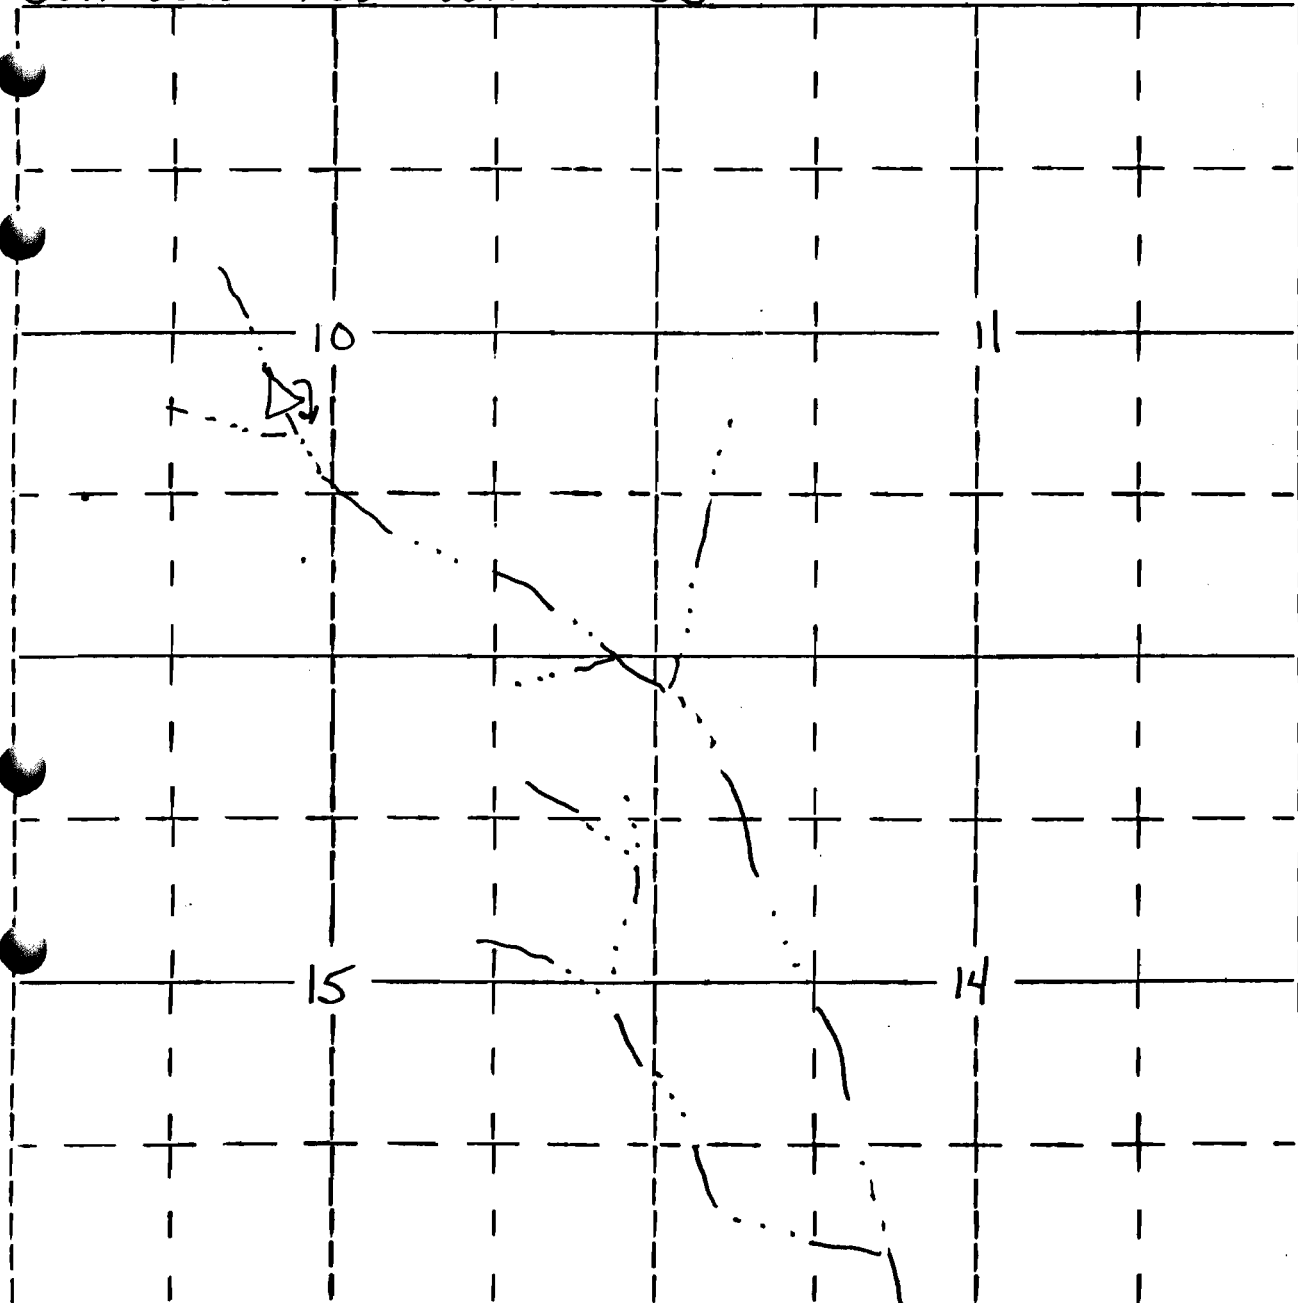

2500' N 2500' E of the SW corner of Section 10

Map Scale