Form OR-010-7300-2
4/83

UNITED STATES
DEPARTMENT OF THE INTERIOR
BUREAU OF LAND MANAGEMENT

Section 25

NE SW

Township 30S

Range 28E

Will. Mer.

Appl. No. R67644

Permit No. R 9503

Loggerhead Canyon Reservoir #0946

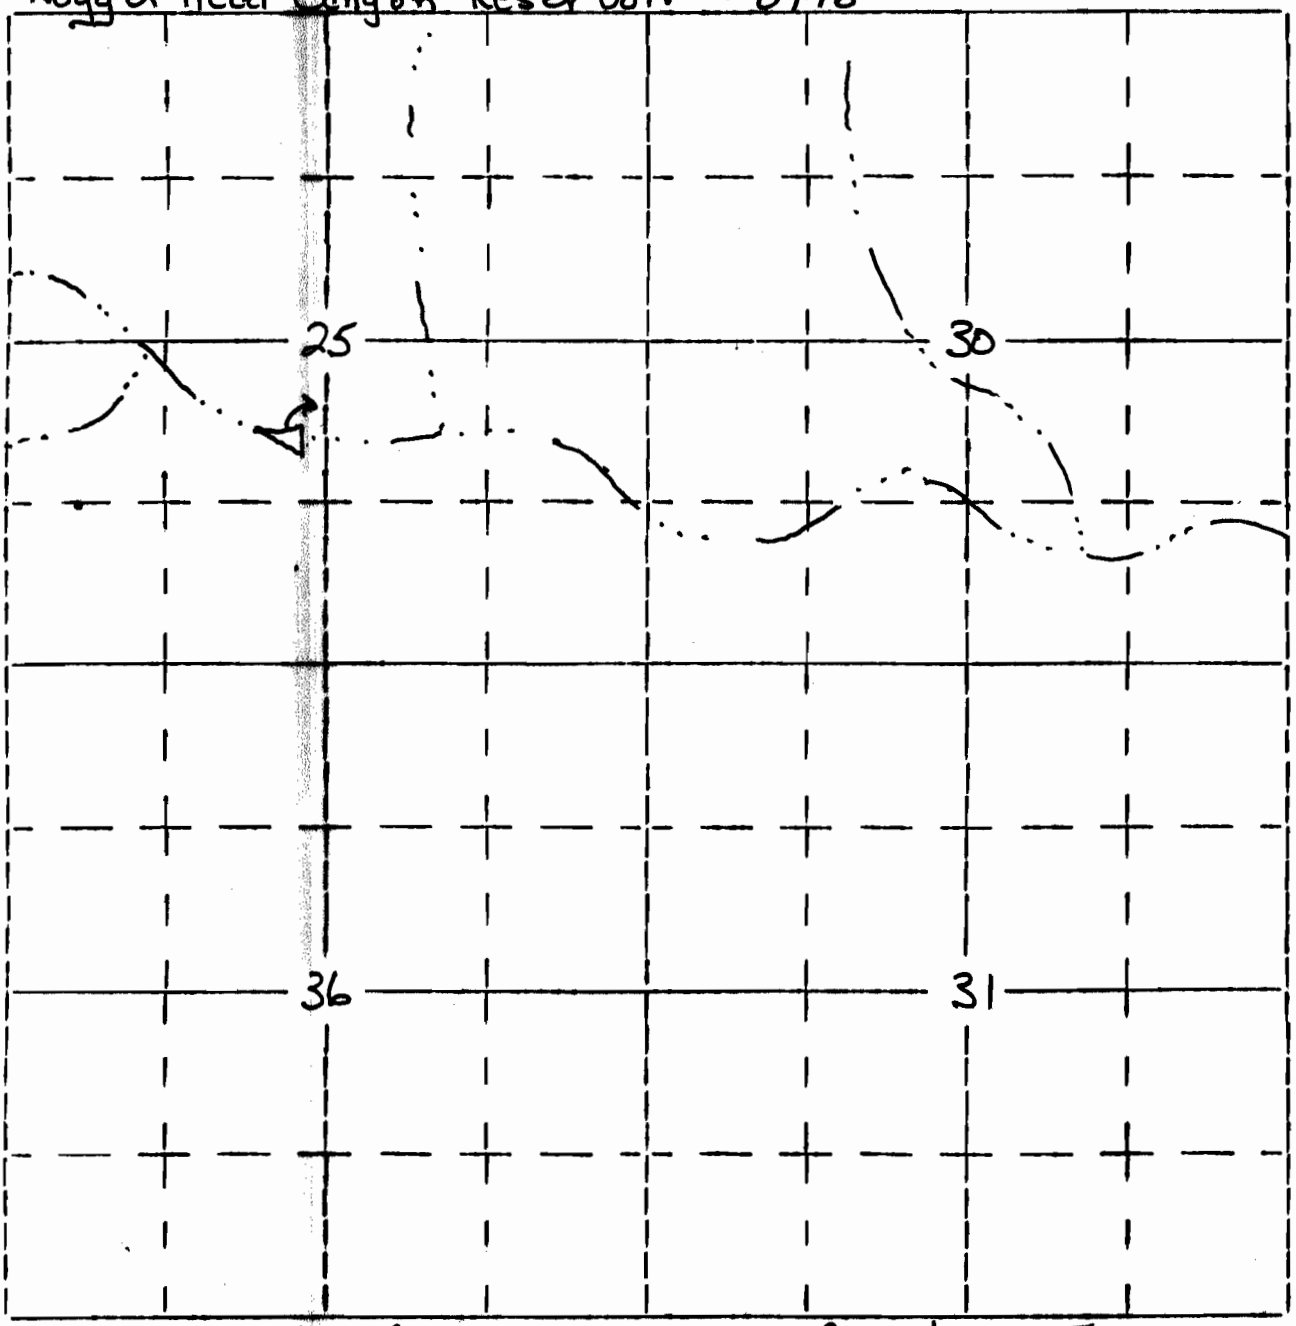

1800' N 2,200' E of the SW corner of section 25

RECEIVED