

Form OR-010-7300-2
4/83

UNITED STATES
DEPARTMENT OF THE INTERIOR
BUREAU OF LAND MANAGEMENT

Section

14

Township 29S

Appl. No. R67645


NW NW

Range 26E

Permit No. R 9504

Will. Mer.

Fitz Reservoir #0948

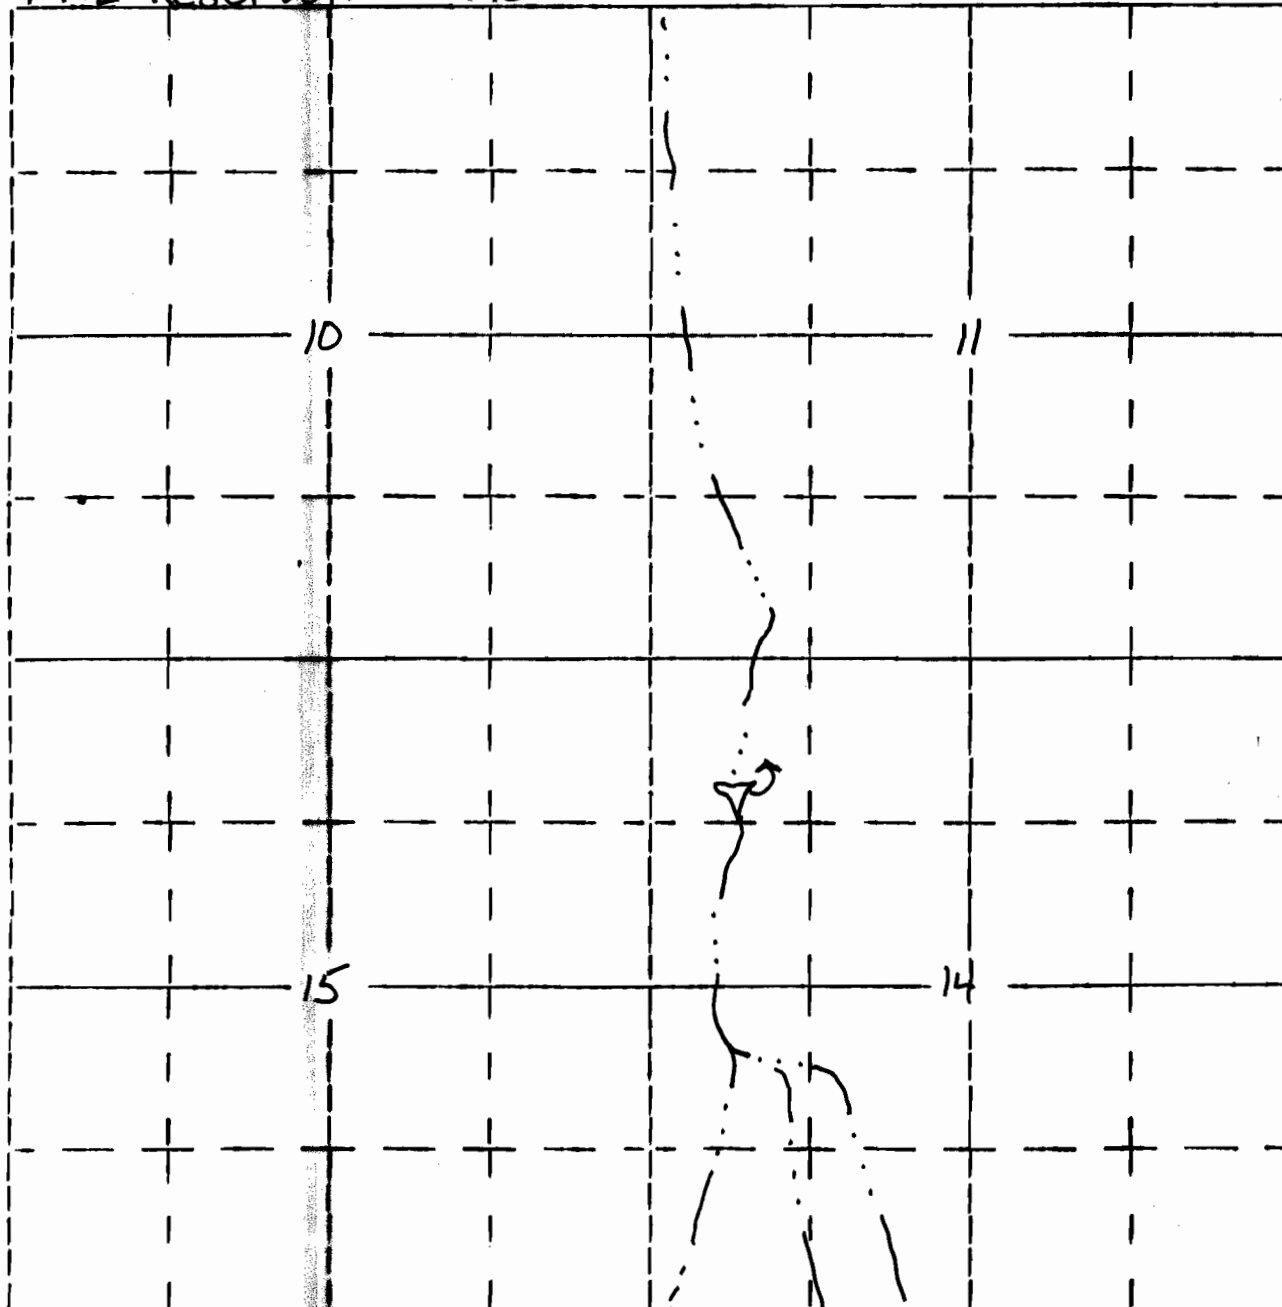

1250'S 950'E of the NW corner of section 14

1250'S 950'E