

R9505
78700

Form OR-010-7300-2
4/83

UNITED STATES
DEPARTMENT OF THE INTERIOR
BUREAU OF LAND MANAGEMENT


Section 16
NE NW

Township 29S
Range 26E

Appl. No. R67646
Permit No. R 9505

Will. Mer.

Frozen Reservoir #0951

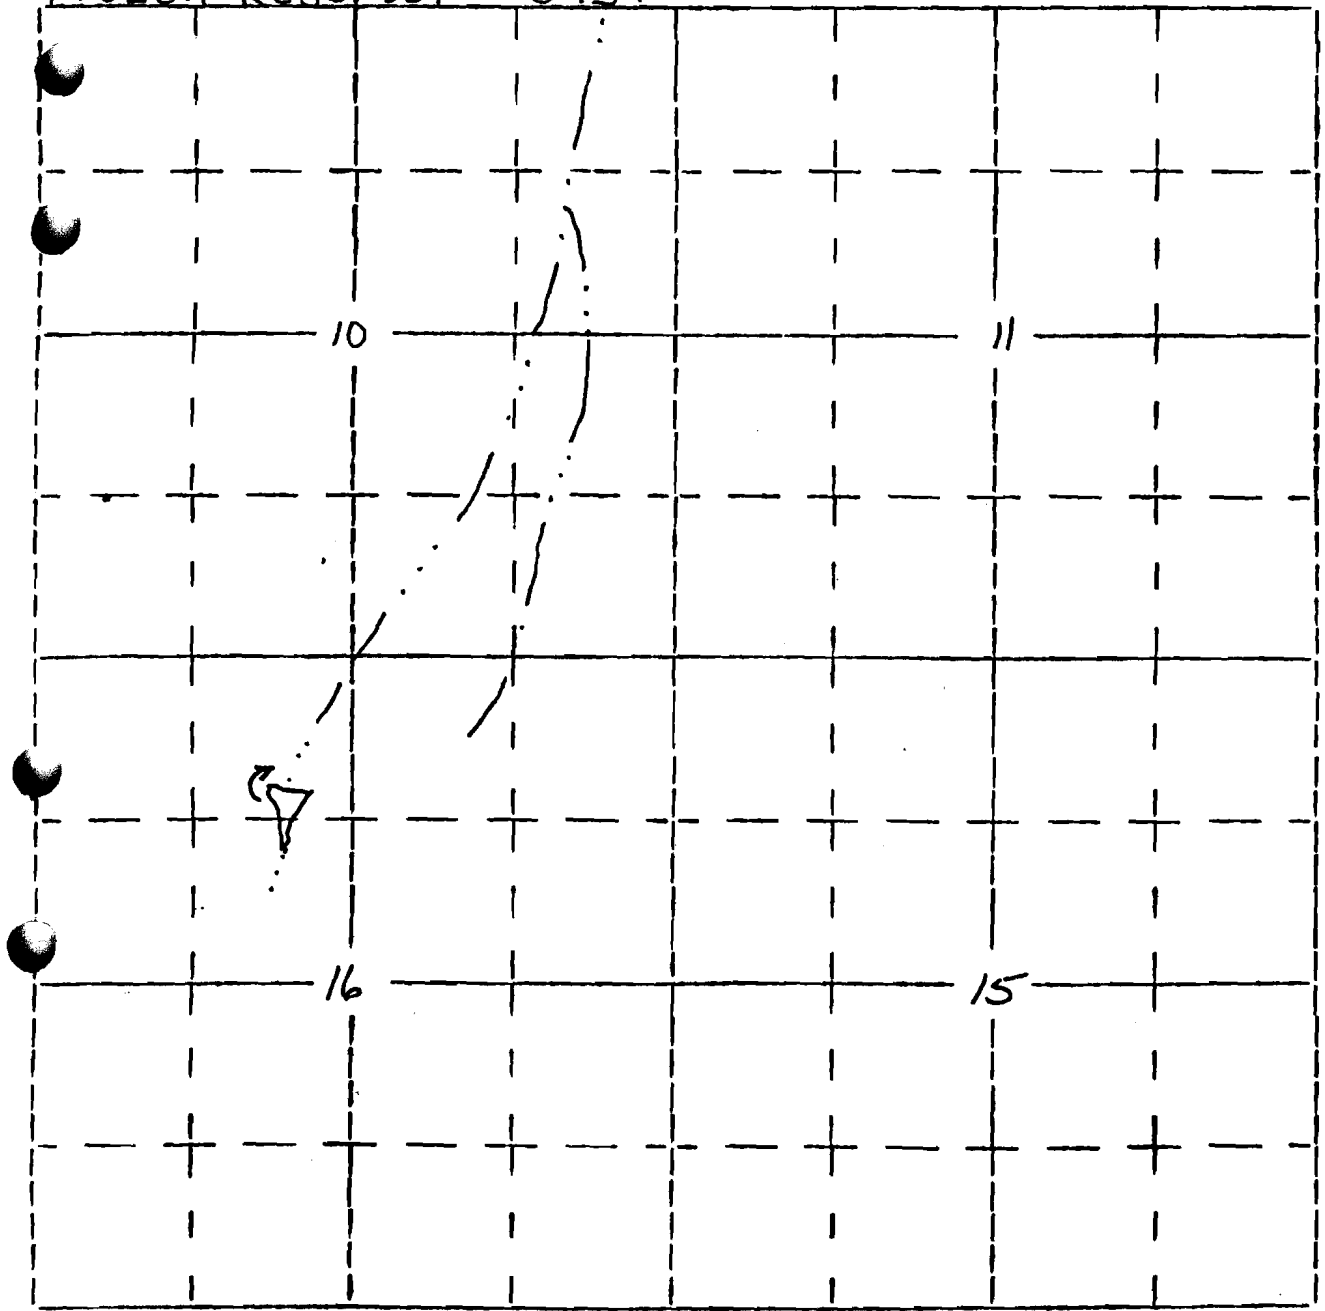

1250'S 2,050'E of the NW corner of section 16