

R9513
78703

Form OR-010-7300-2
4/83


UNITED STATES
DEPARTMENT OF THE INTERIOR
BUREAU OF LAND MANAGEMENT

Section
13
SW NE

Township 25 south
Range 16 east

Appl. No. R67656
Permit No. R 9513

Ice Caves Pot Hole Reservoir (#0708)

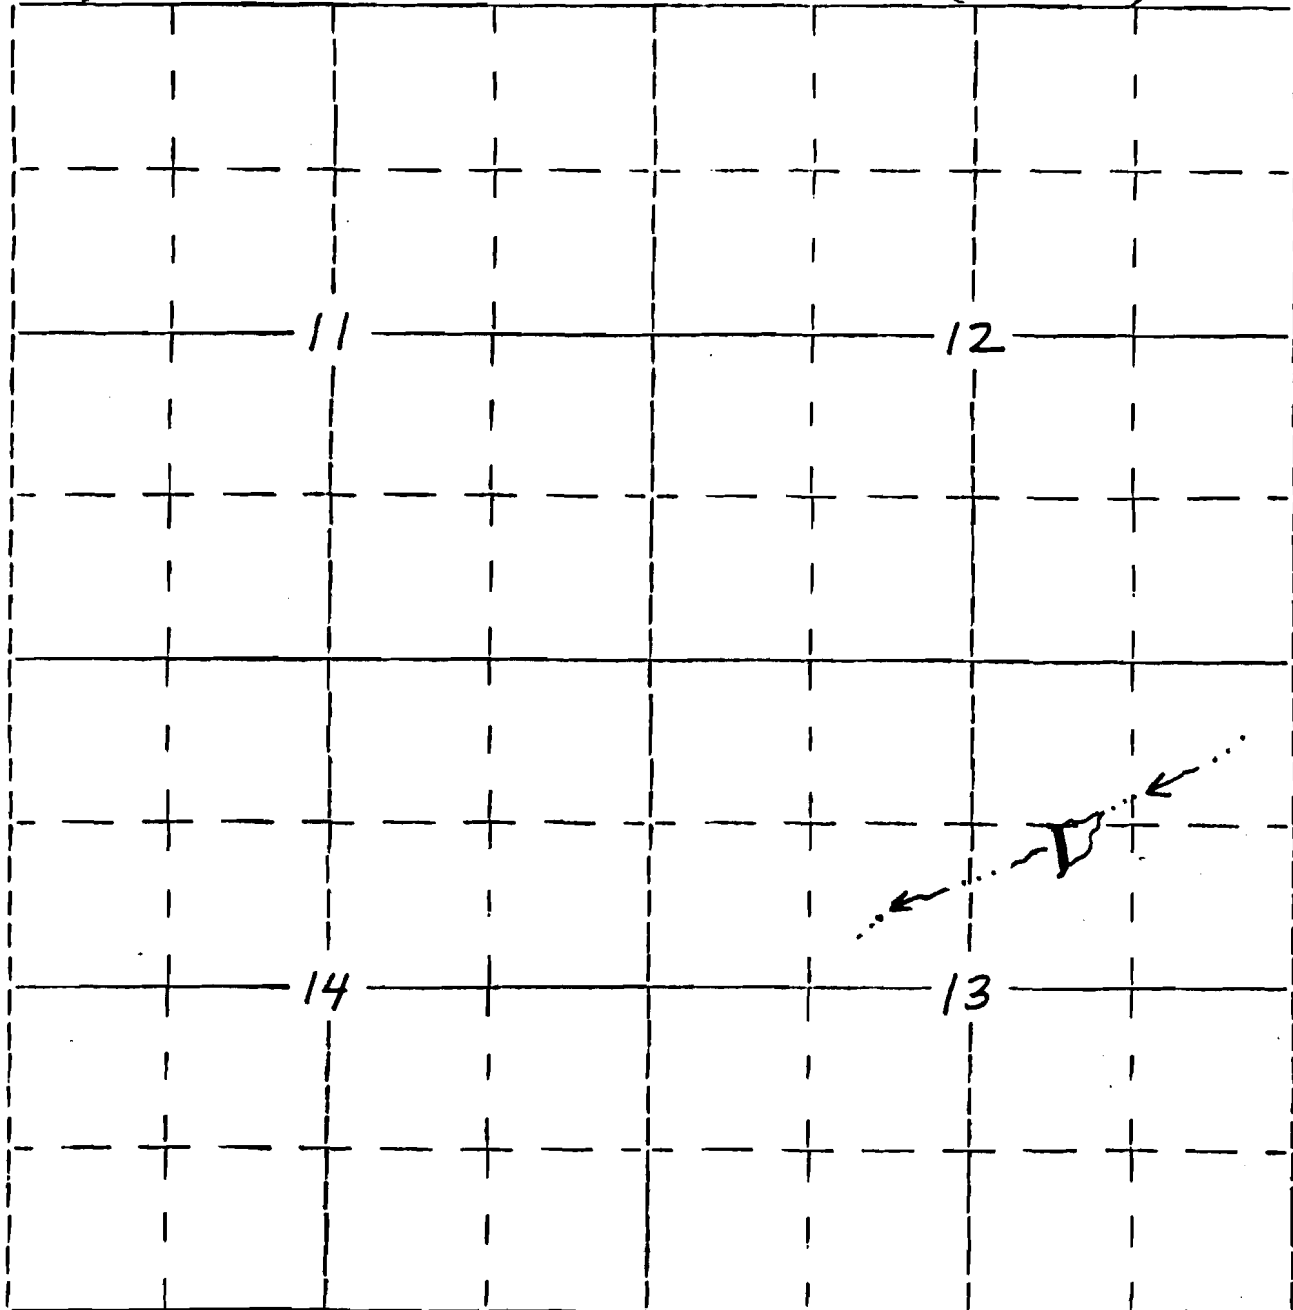

1475' S., 2005' W. of NE Corner of section 13

11000000