

R9523
78705

Form OR-010-7300-2
4/83


UNITED STATES
DEPARTMENT OF THE INTERIOR
BUREAU OF LAND MANAGEMENT

Section 15
SE SE

Township 28 south
Range 18 east

Appl. No. R67667
Permit No. R 9523

Horse Corral Reservoir (#4023)

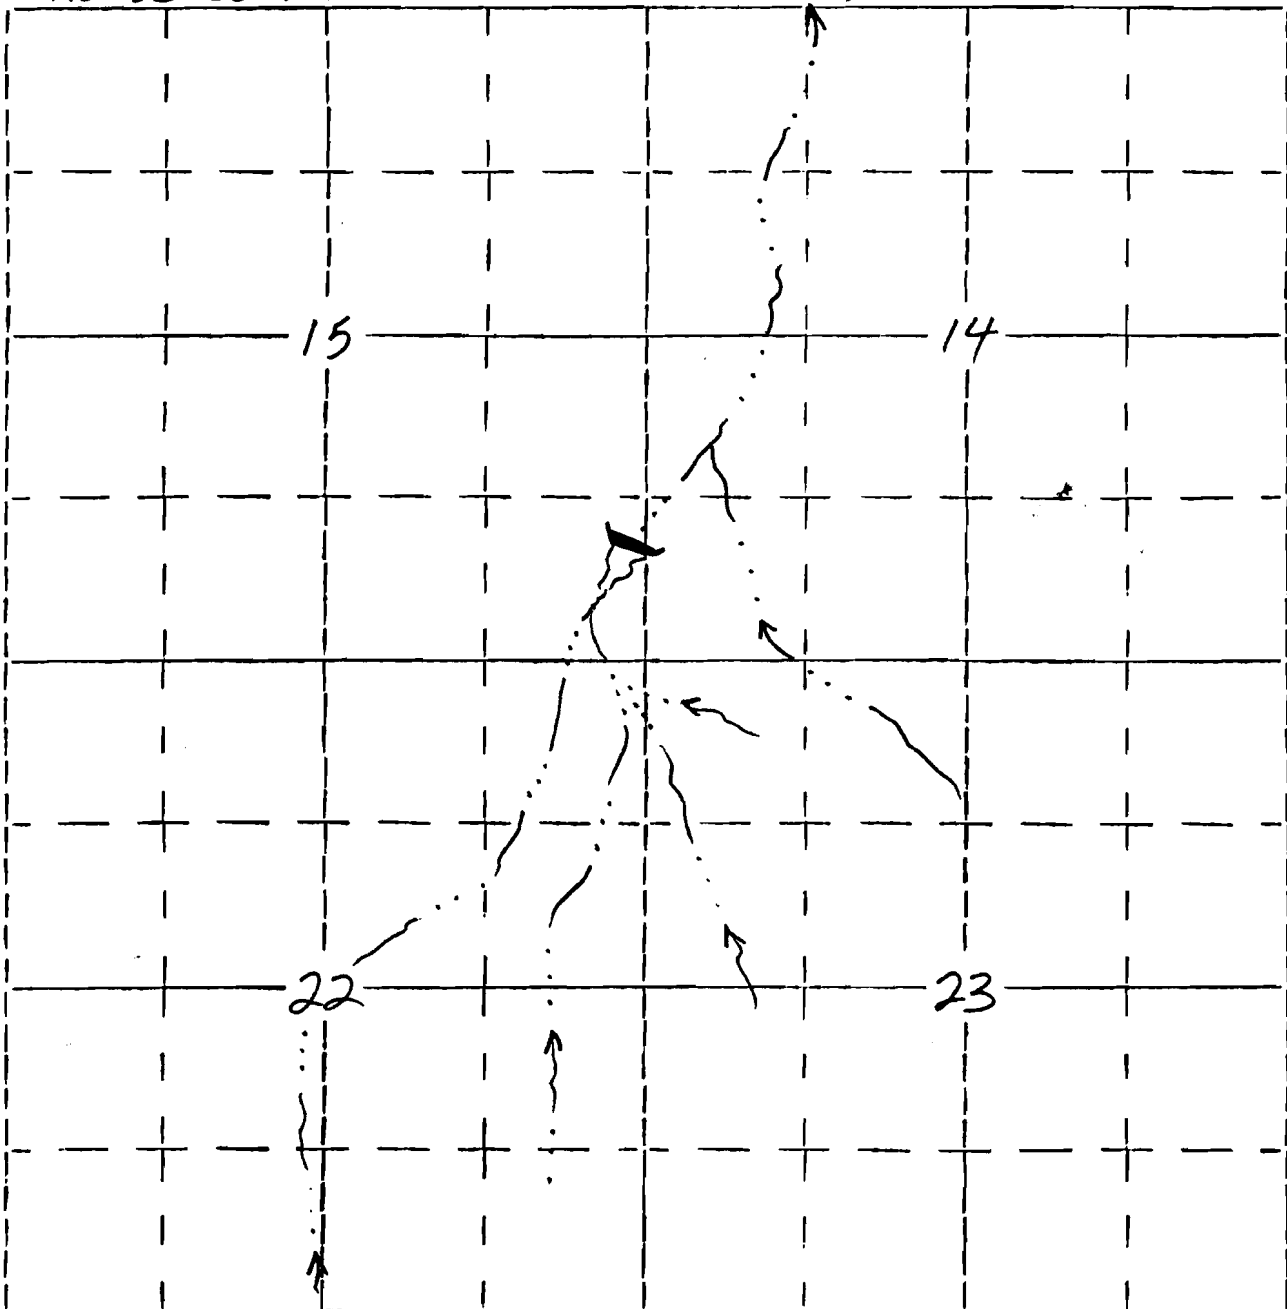

950' N., 160' W. of the SE corner, section 15