

R9525

78706

Form OR-010-7300-2
4/83UNITED STATES
DEPARTMENT OF THE INTERIOR
BUREAU OF LAND MANAGEMENT

Section

29Township 28 south
Range 18 east


Appl. No.

R67669

Permit No.

R 9525

St. Patrick Reservoir (#4092)

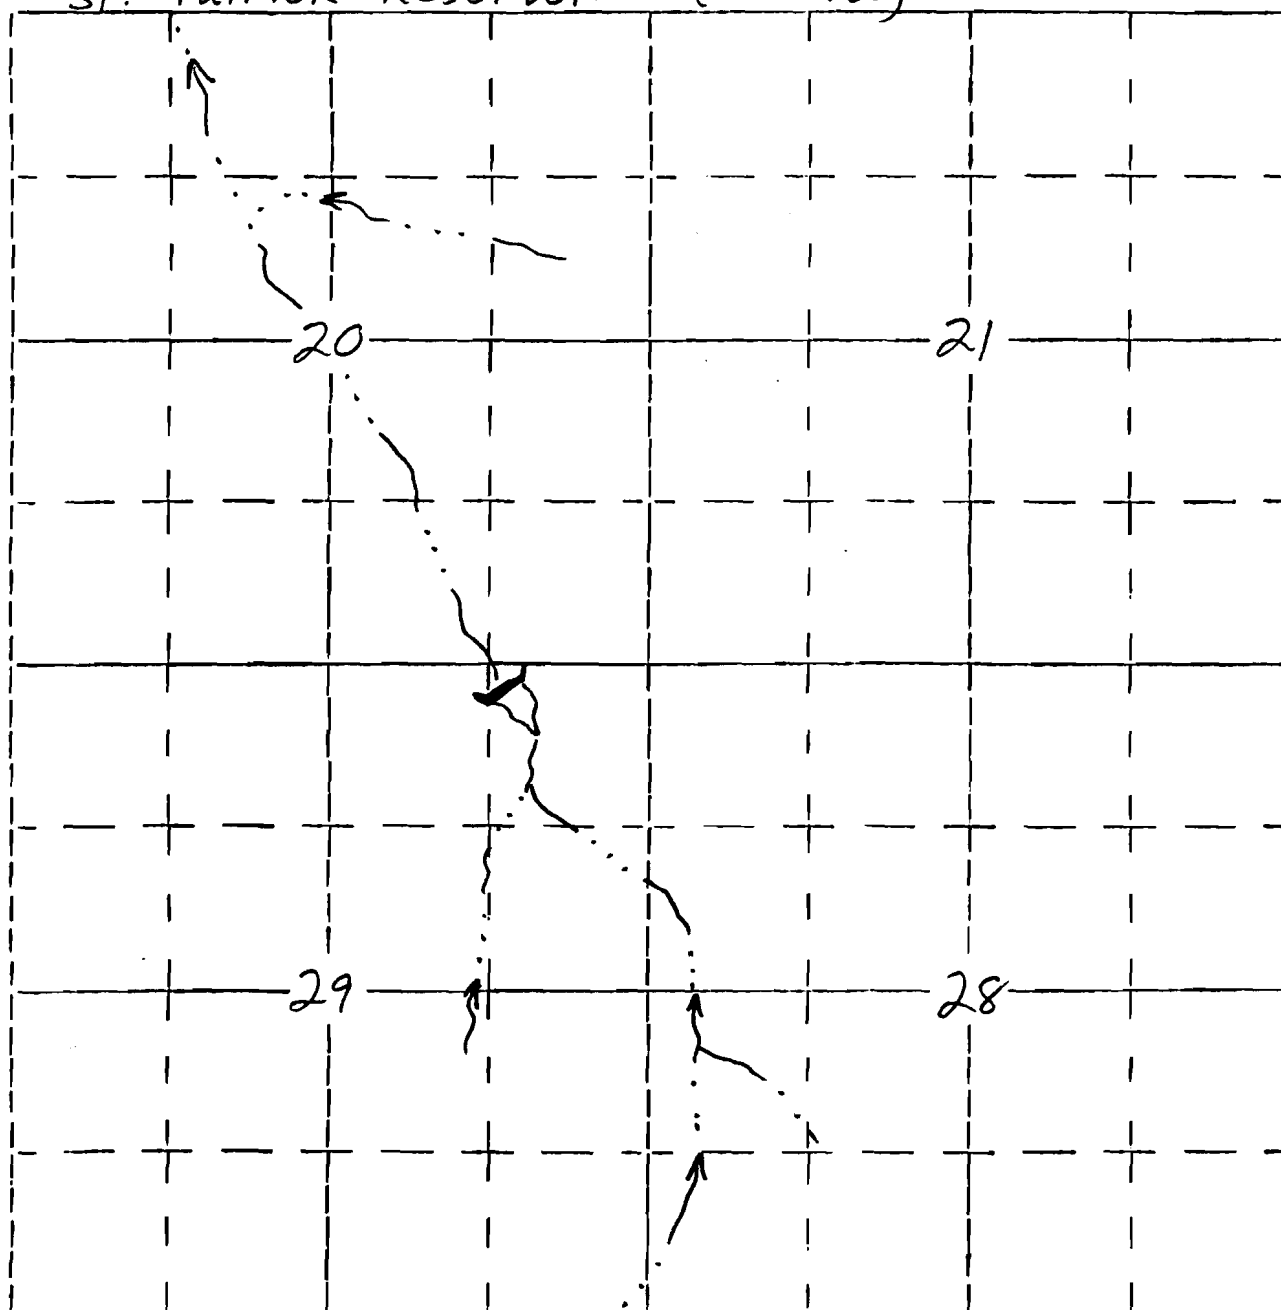

160' S., 1160' W. of NE Corner, Section 29

R050