

R9527
78707

Form OR-010-7300-2
4/83


UNITED STATES
DEPARTMENT OF THE INTERIOR
BUREAU OF LAND MANAGEMENT

Section
25
NWSE

Township 35 South
Range 19 east

Appl. No. R67671
Permit No. R 9527

Clower Flat Res. (#5380)

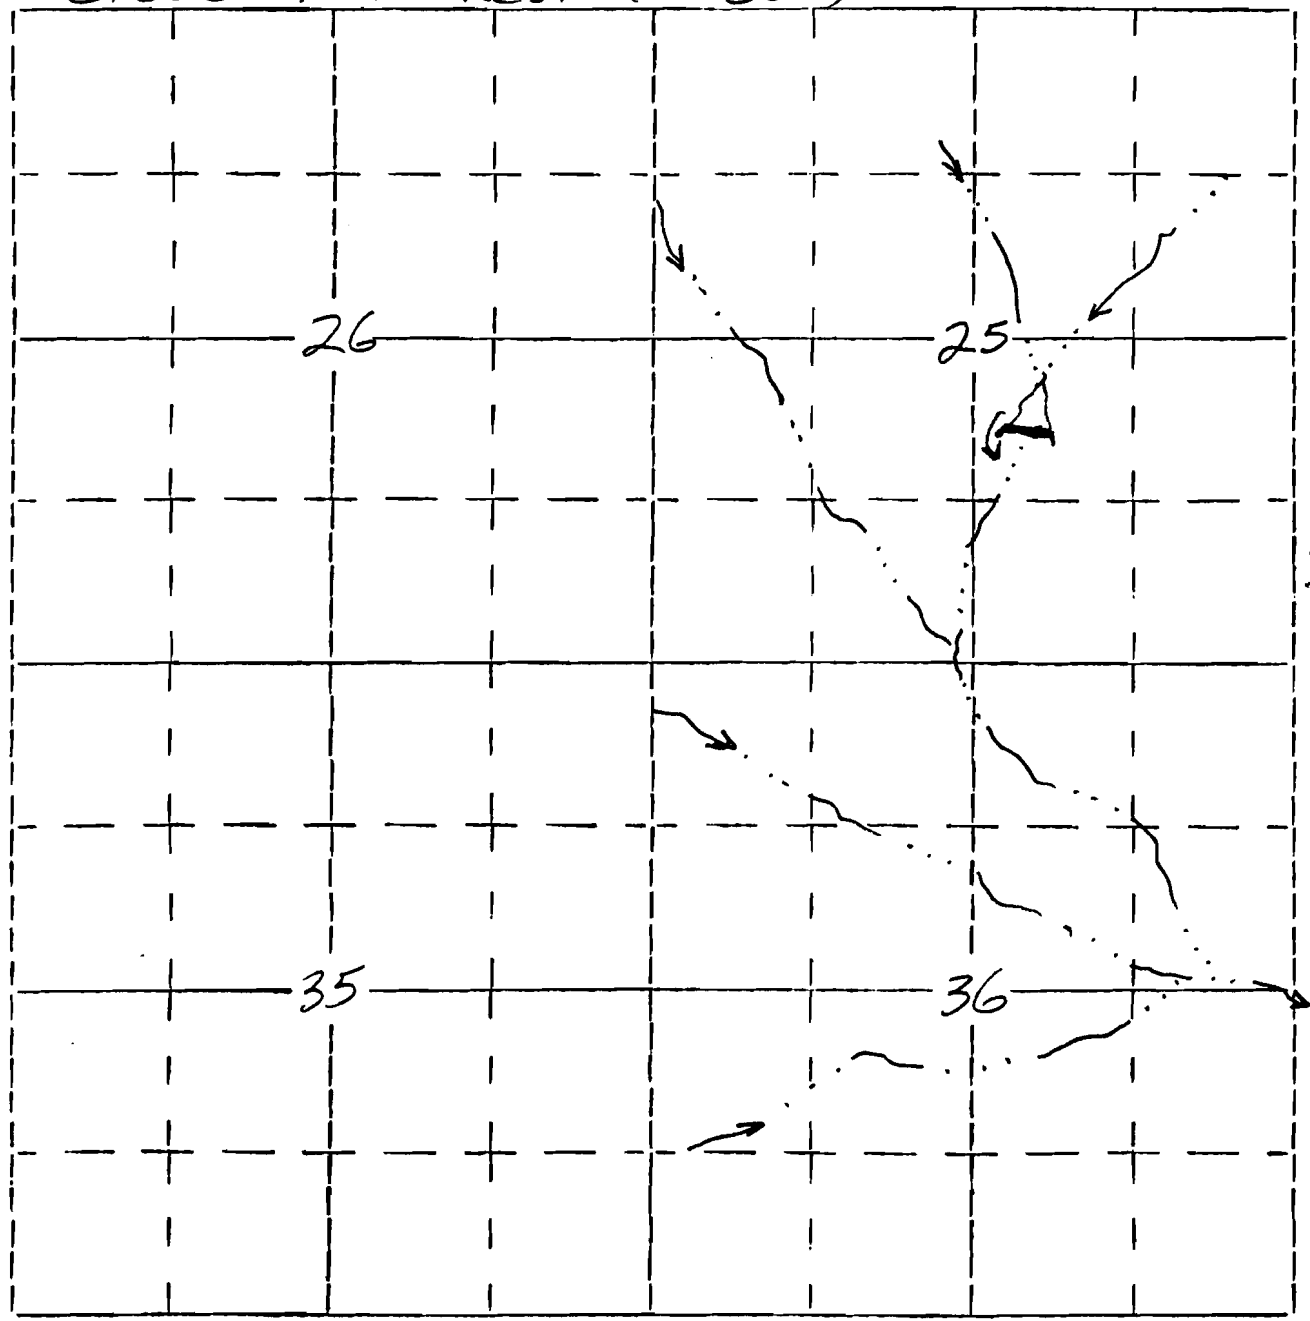

1900' N., 2165' W. of SE Corner, section 25

1862224