

R9530
78708

Form OR-010-7300-2
4/83

UNITED STATES
DEPARTMENT OF THE INTERIOR
BUREAU OF LAND MANAGEMENT

Section

11

SW SW


Township 29 south
Range 16 east

Appl. No. R67674

Permit No. R 9530

Egli Rim Reservoir #2

5248

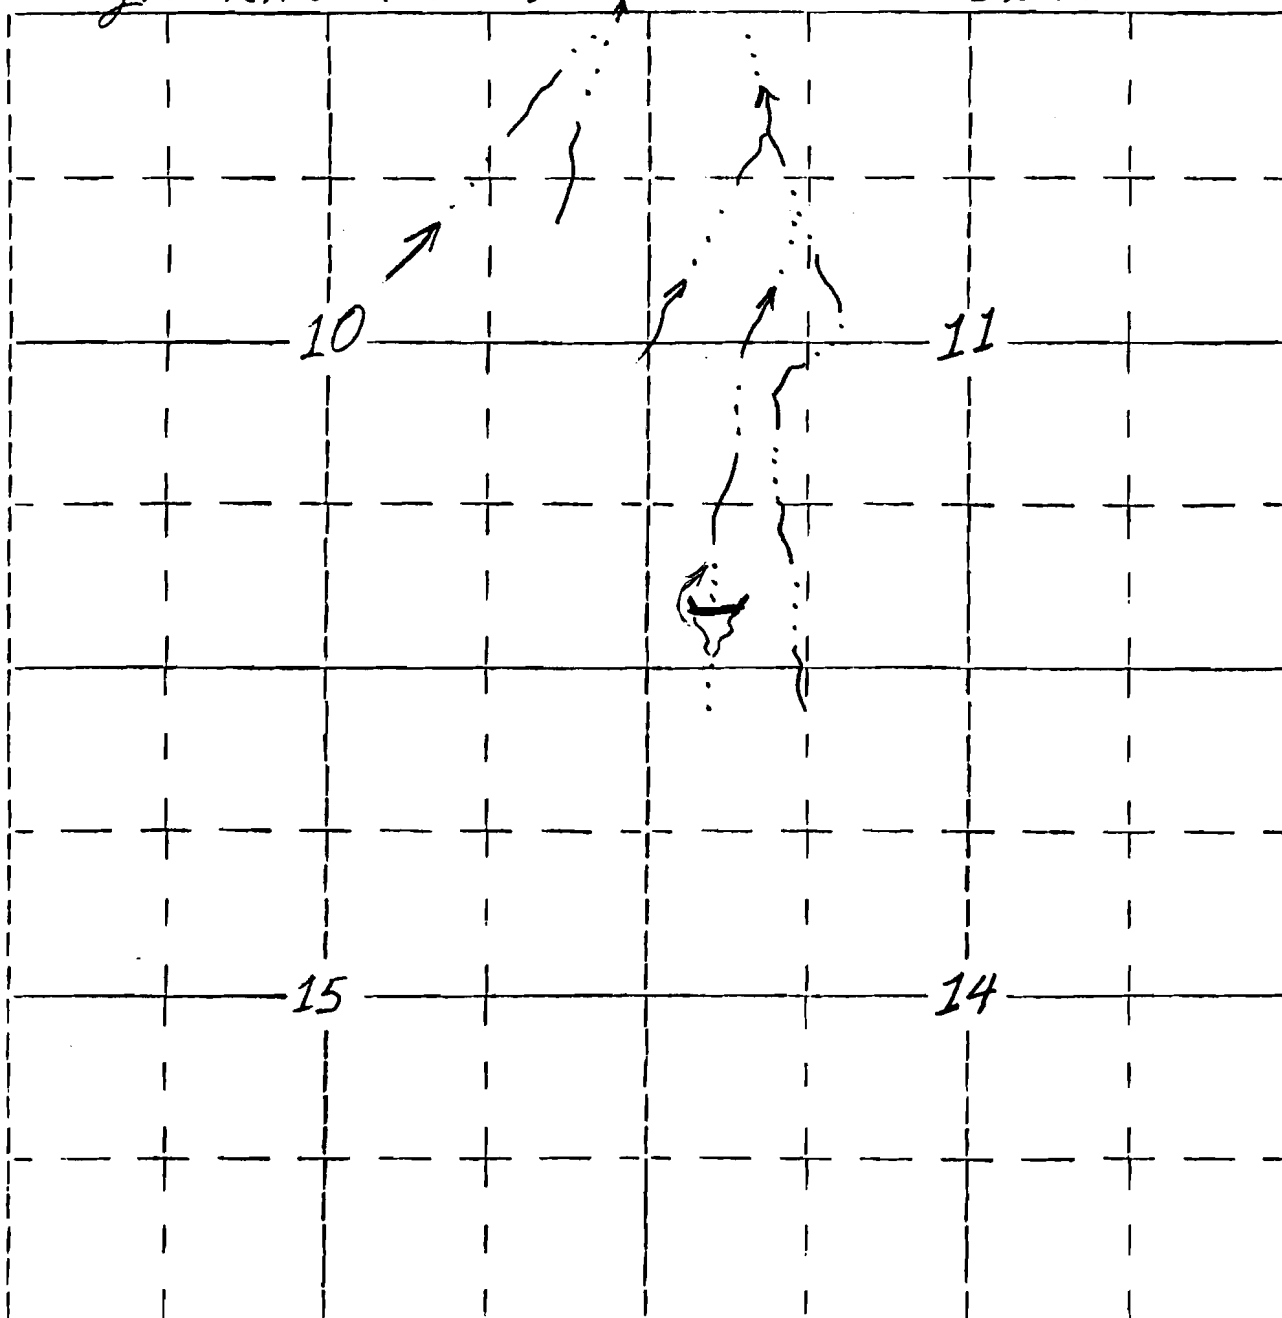

845' N., 605 E., of SW corner, section 11