

R 9586
78709

Form OR-010-7300-2
4/83

UNITED STATES
DEPARTMENT OF THE INTERIOR
BUREAU OF LAND MANAGEMENT

Section

18


Township 29 south

Range 16 east

Appl. No. R-67778

Permit No. R 9586

Gary & Rich W.H. #2 (#5309)

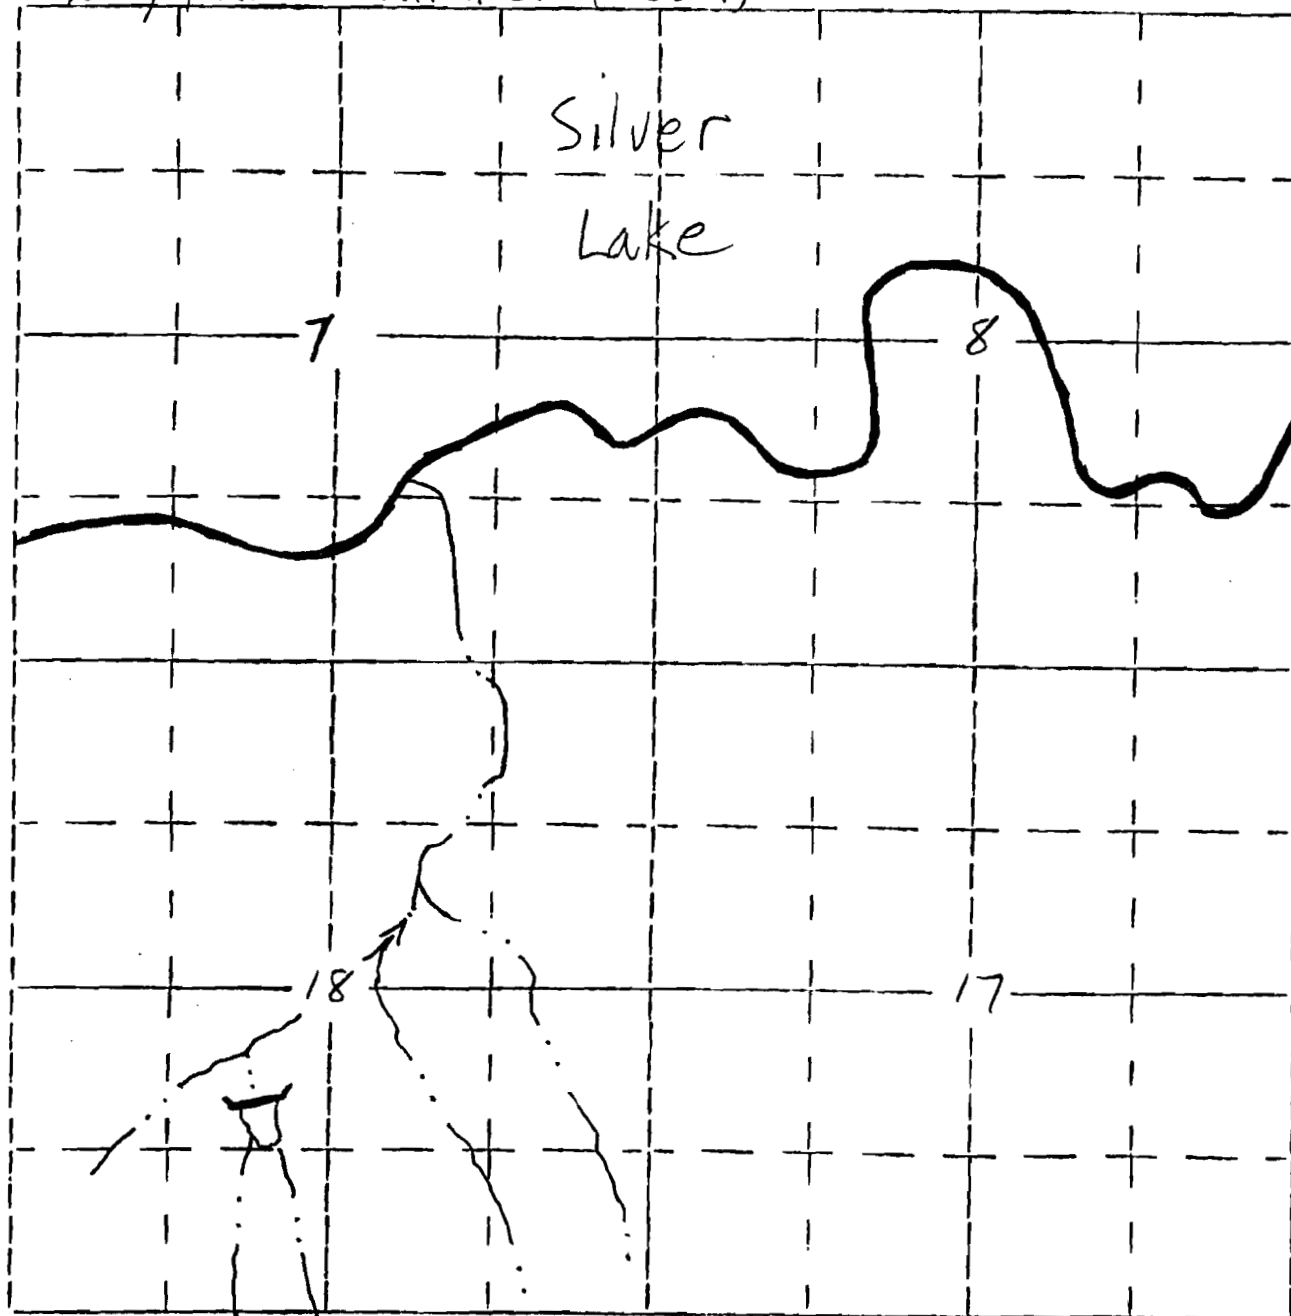

1705' N., 2050' E. of SW corner, sec. 18