

R9589
78710

Form OR-010-7300-2
4/83

UNITED STATES
DEPARTMENT OF THE INTERIOR
BUREAU OF LAND MANAGEMENT

Section

21

SESE

OCT 14 1983

WATER RESOURCES DEPT.


SALEM, OREGON

Range 16 east

Appl. No. R-67781

Permit No. R 9589

Powerline Res. (#5249)

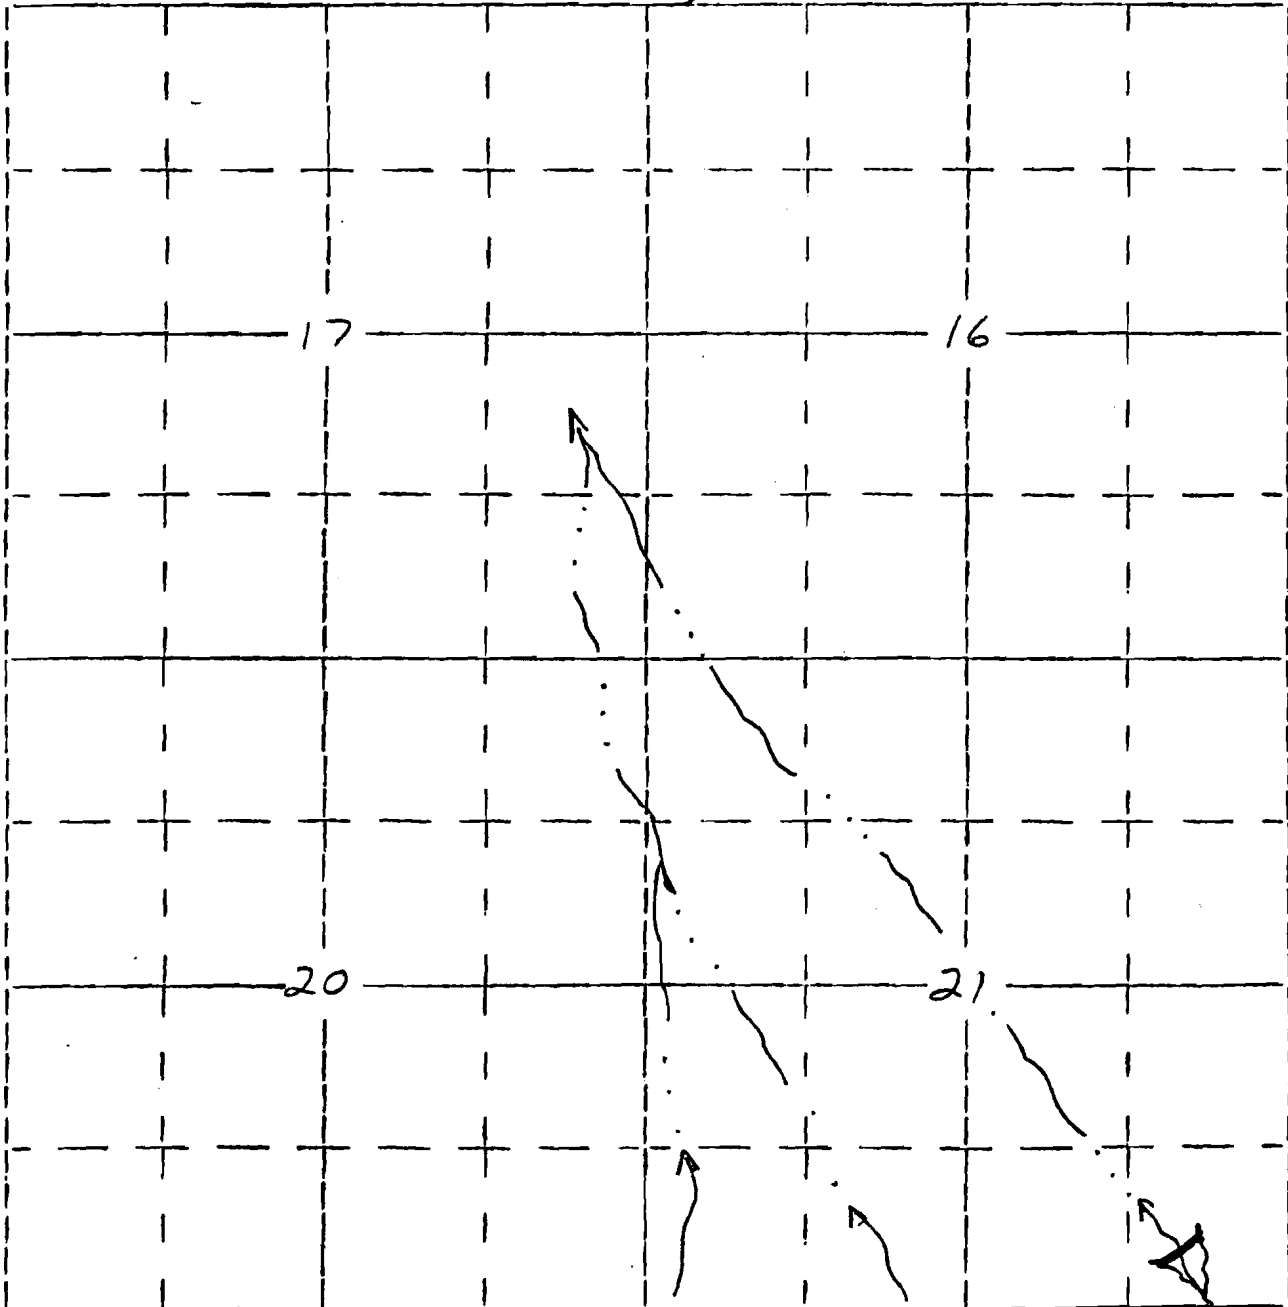

225' N., 910' W. OF SE Corner, sec. 21