

R9590
78711

Form OR-010-7300-2
4/83


UNITED STATES
DEPARTMENT OF THE INTERIOR
BUREAU OF LAND MANAGEMENT

Section 7 Town. 28 south
NENW Range 13 east

Appl. No. R-67782

Permit No. R 9590

South Ward Lake Res. (#5264)

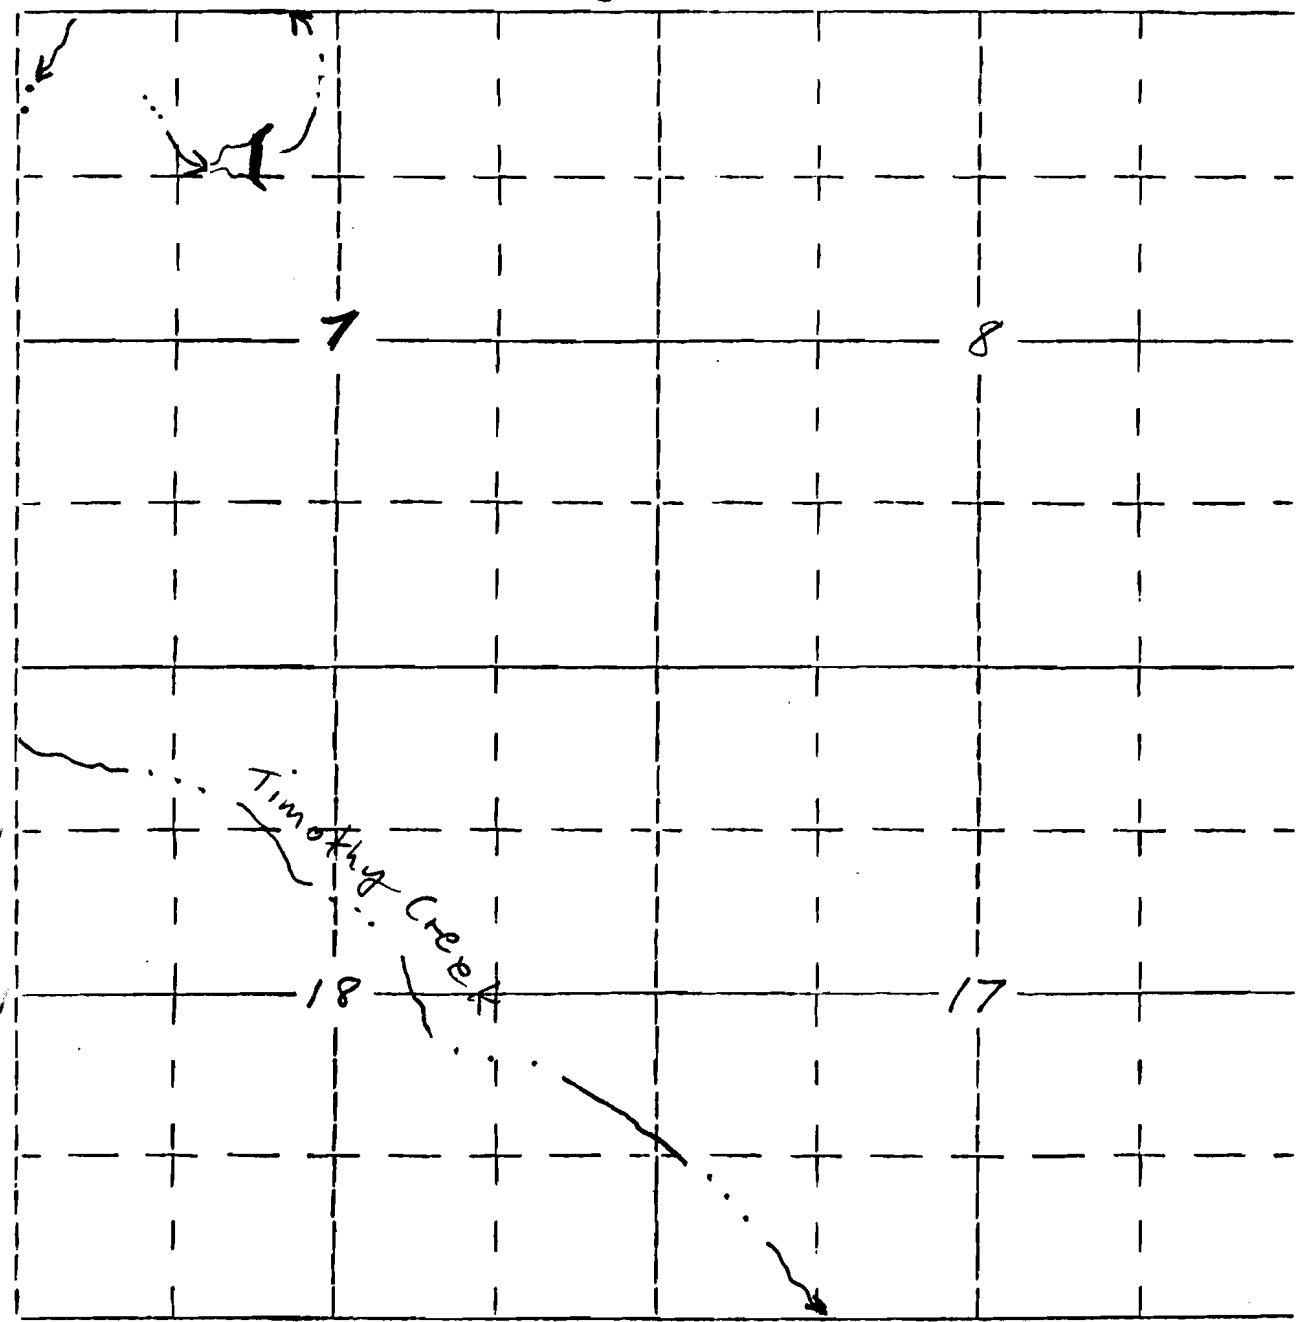

1260' S., 1980' E. of NW Corner, Sec. 7

RECEIVED
OCT 14 1983
WATER RESOURCES DEPT.
SALEM, OREGON