

R9592
78712

Form OR-010-7300-2
4/83

UNITED STATES
DEPARTMENT OF THE INTERIOR
BUREAU OF LAND MANAGEMENT

Section


13
SWSW

Township 29 south
Range 15 east

Appl. No. R-67784

Permit No. R 9592

Rim Waterhole #1 (#5310)

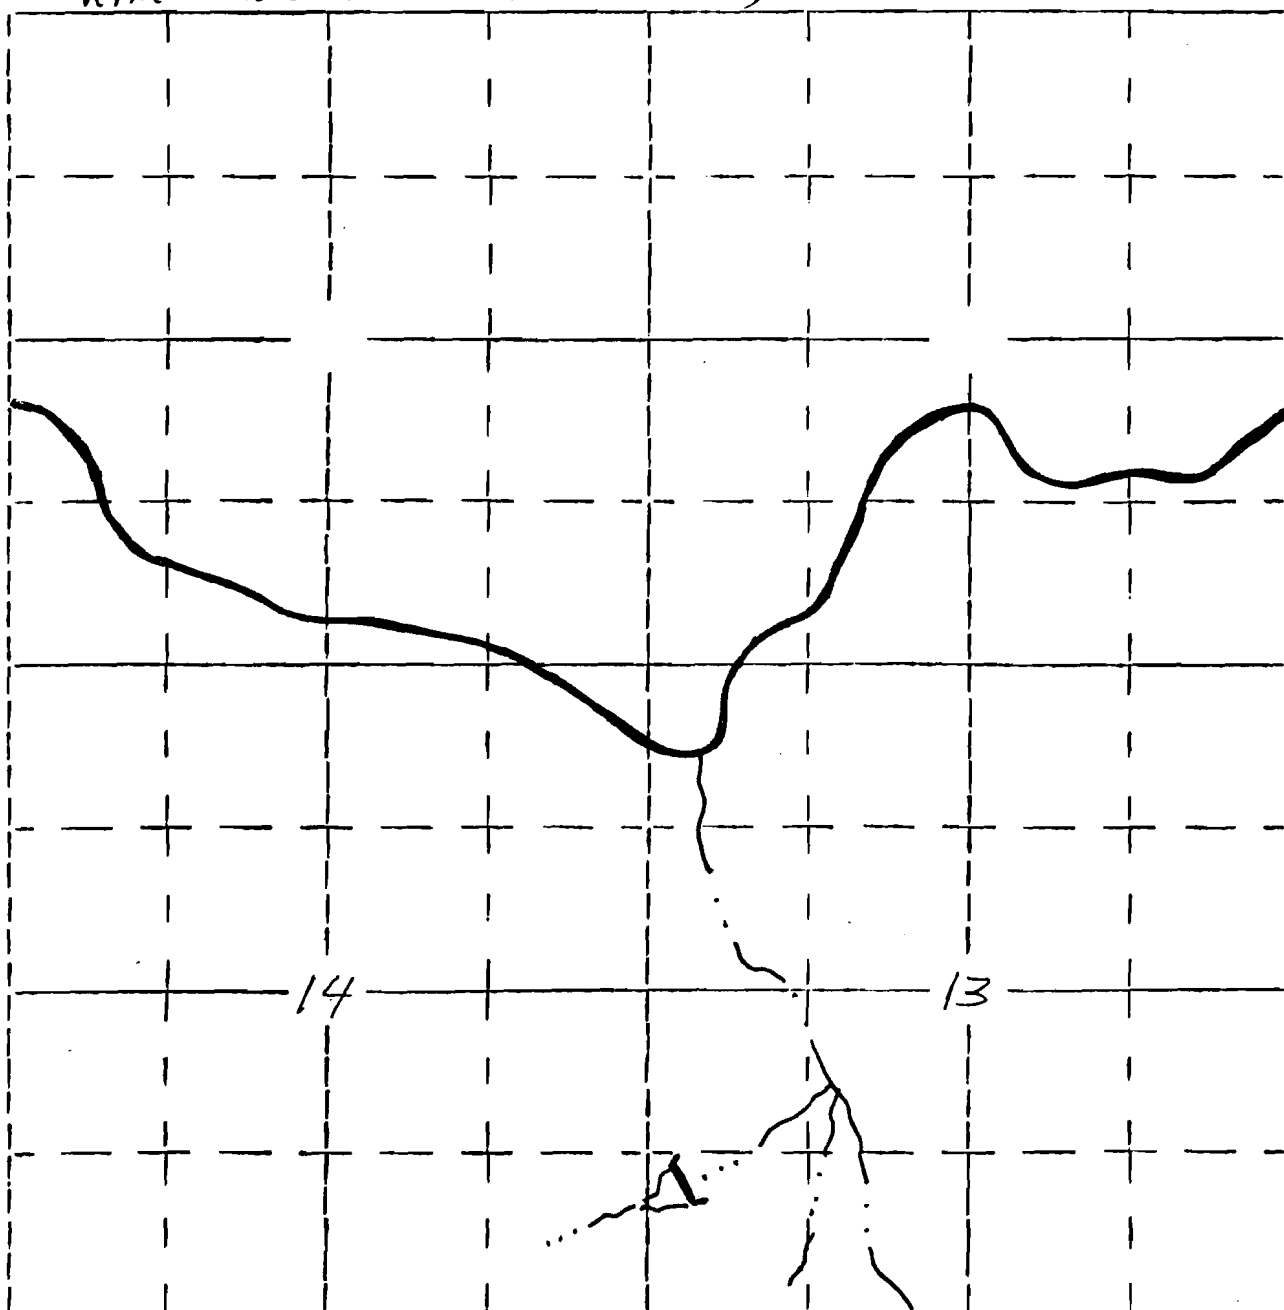

1130' N., 190' E. of SW corner, section 13

RECEIVED
OCT 1 1983
WATER RESOURCES DEPT.
SALEM, OREGON