

Form OR-010-7300-2
4/83

UNITED STATES
DEPARTMENT OF THE INTERIOR
BUREAU OF LAND MANAGEMENT


Section
13
SESE

Township 29 south
Range 15 east

Appl. No. R-67786

Permit No. R 9594

Medusahead Res. (#5261)

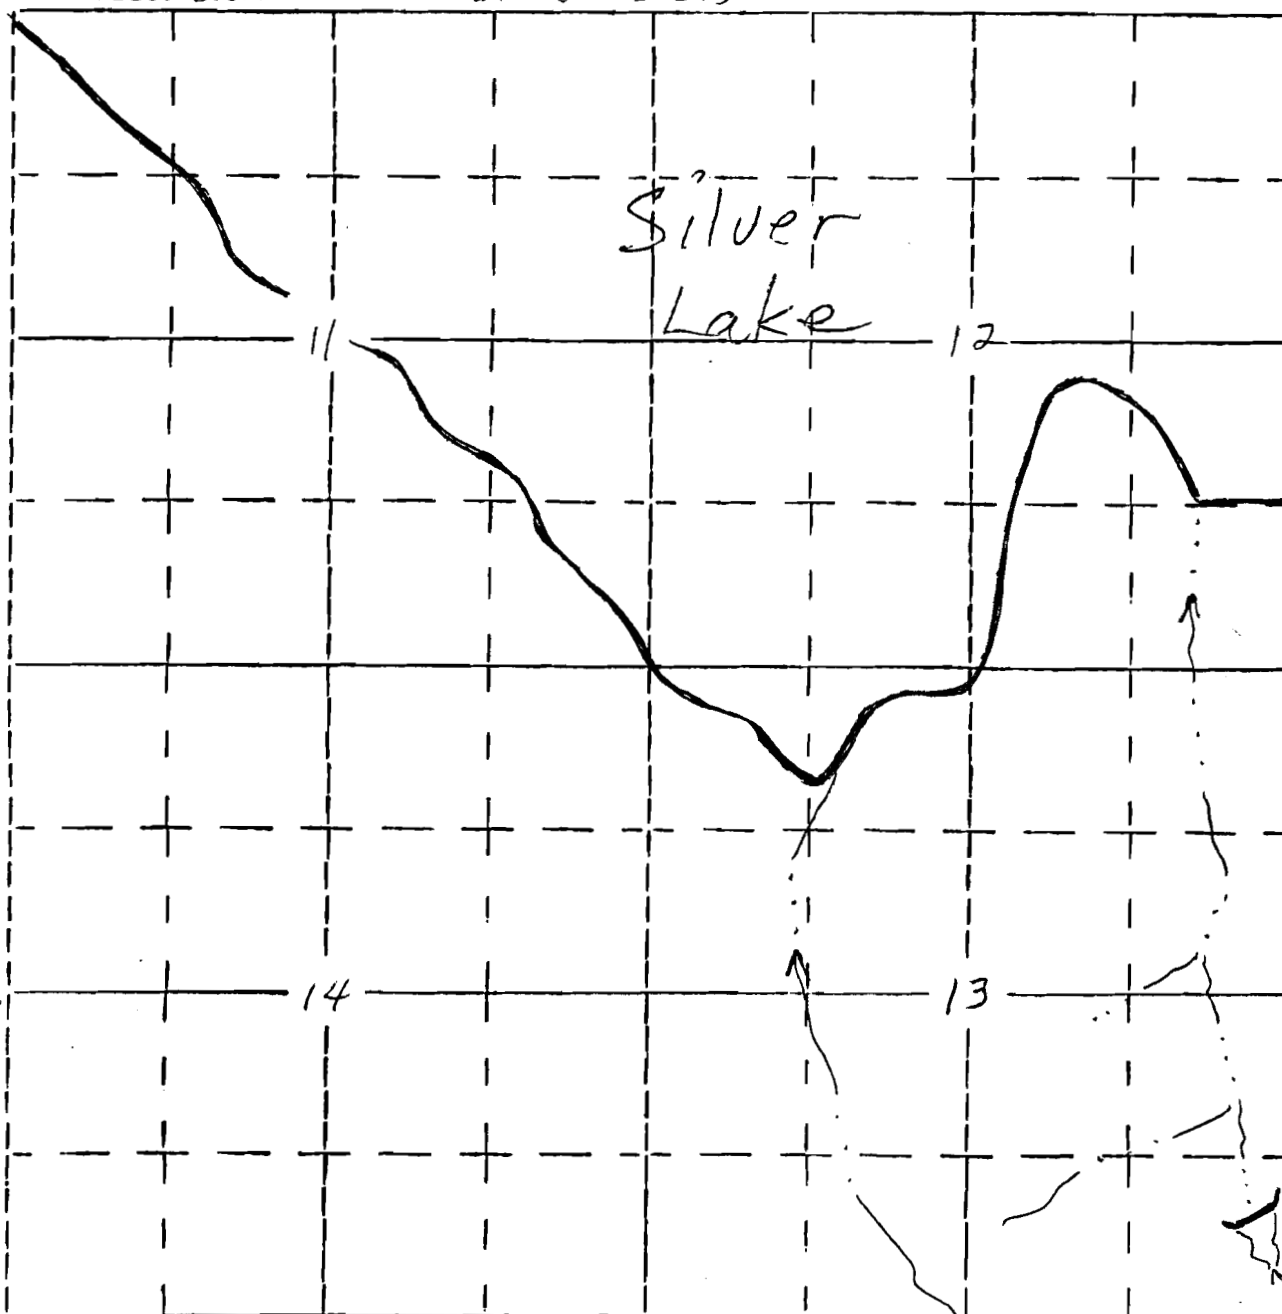

805' N., 185' W. of SE corner, sec. 13

RECEIVED
OCT 14 1983
WATER RESOURCES DEPT.
SALEM, OREGON

RECEIVED
OCT 1 1983
SALEM, OREGON