

Form OR-010-7300-2
4/83

UNITED STATES
DEPARTMENT OF THE INTERIOR
BUREAU OF LAND MANAGEMENT

Section

5

Town. 29 south.

SW NE

Range 15 east


Appl. No. R-67787

Permit No. **R 9595**

OCT 1 1983

WATER RESOURCES DEPT.
SALEM, OREGON

Check Diversions #62

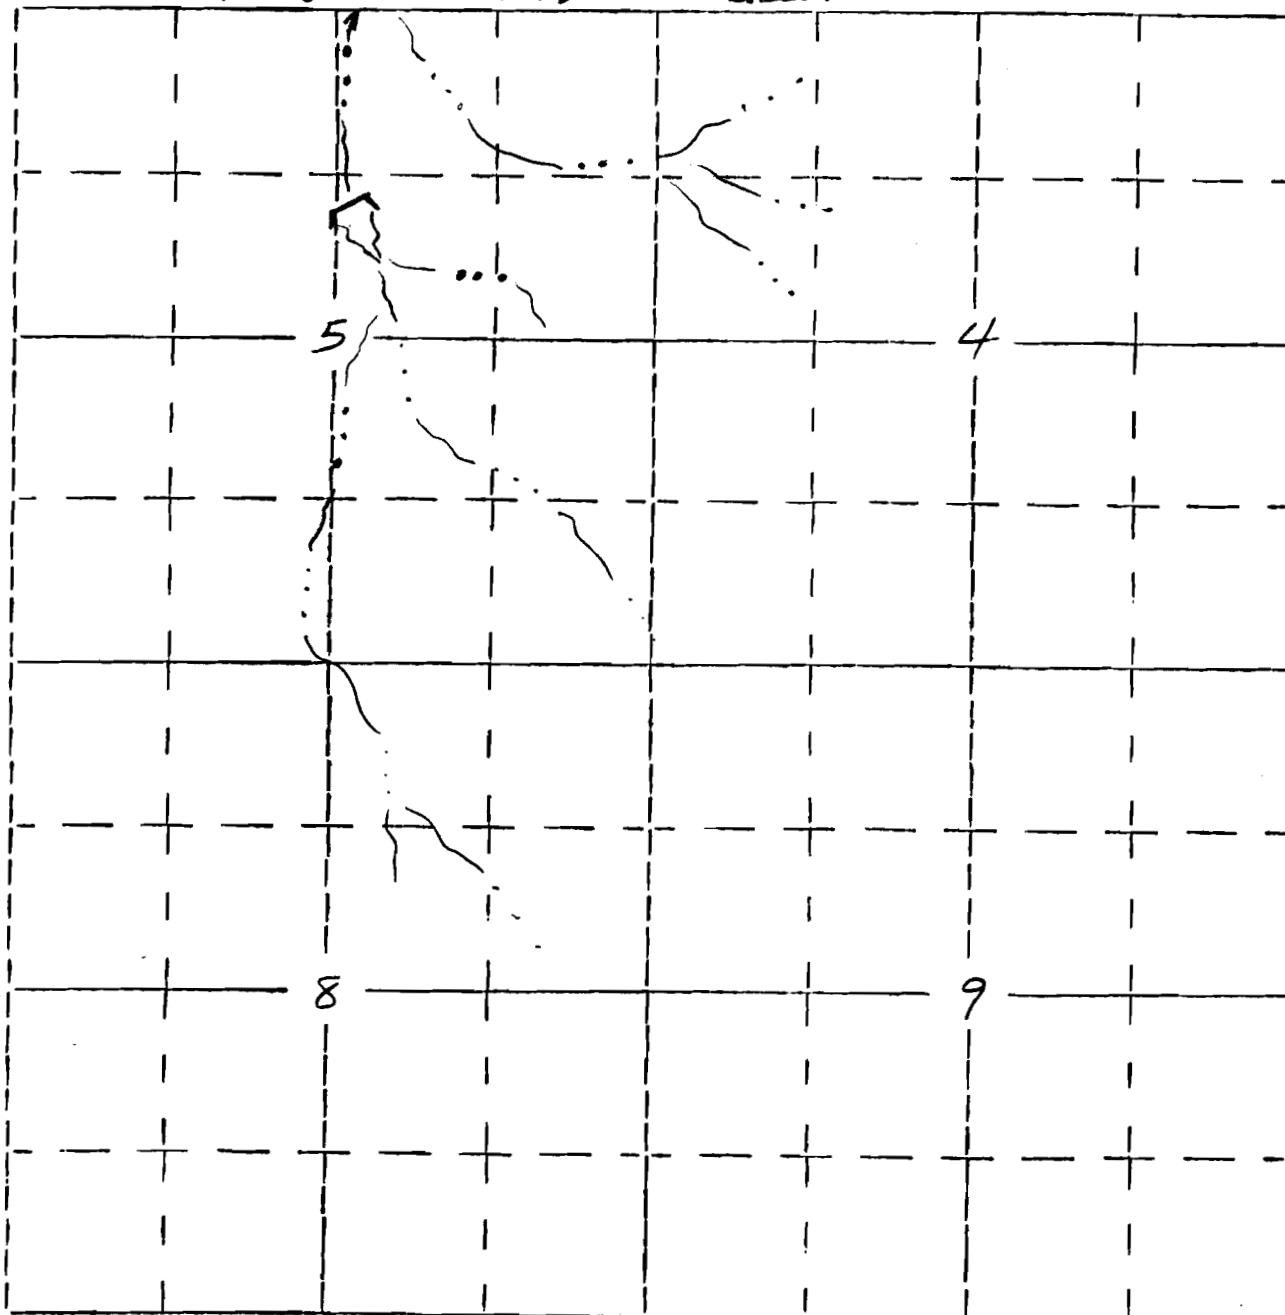

1500' S., 2550' W. of NE Corner, section 5