

R9598
78715

Form OR-010-7300-2
4/83

UNITED STATES
DEPARTMENT OF THE INTERIOR
BUREAU OF LAND MANAGEMENT

Section

3


SW SW

Township 36 S.
Range 20 E.

Appl. No. R-67790

Permit No. R 9598

Coyote Creek Reservoir (#4671)

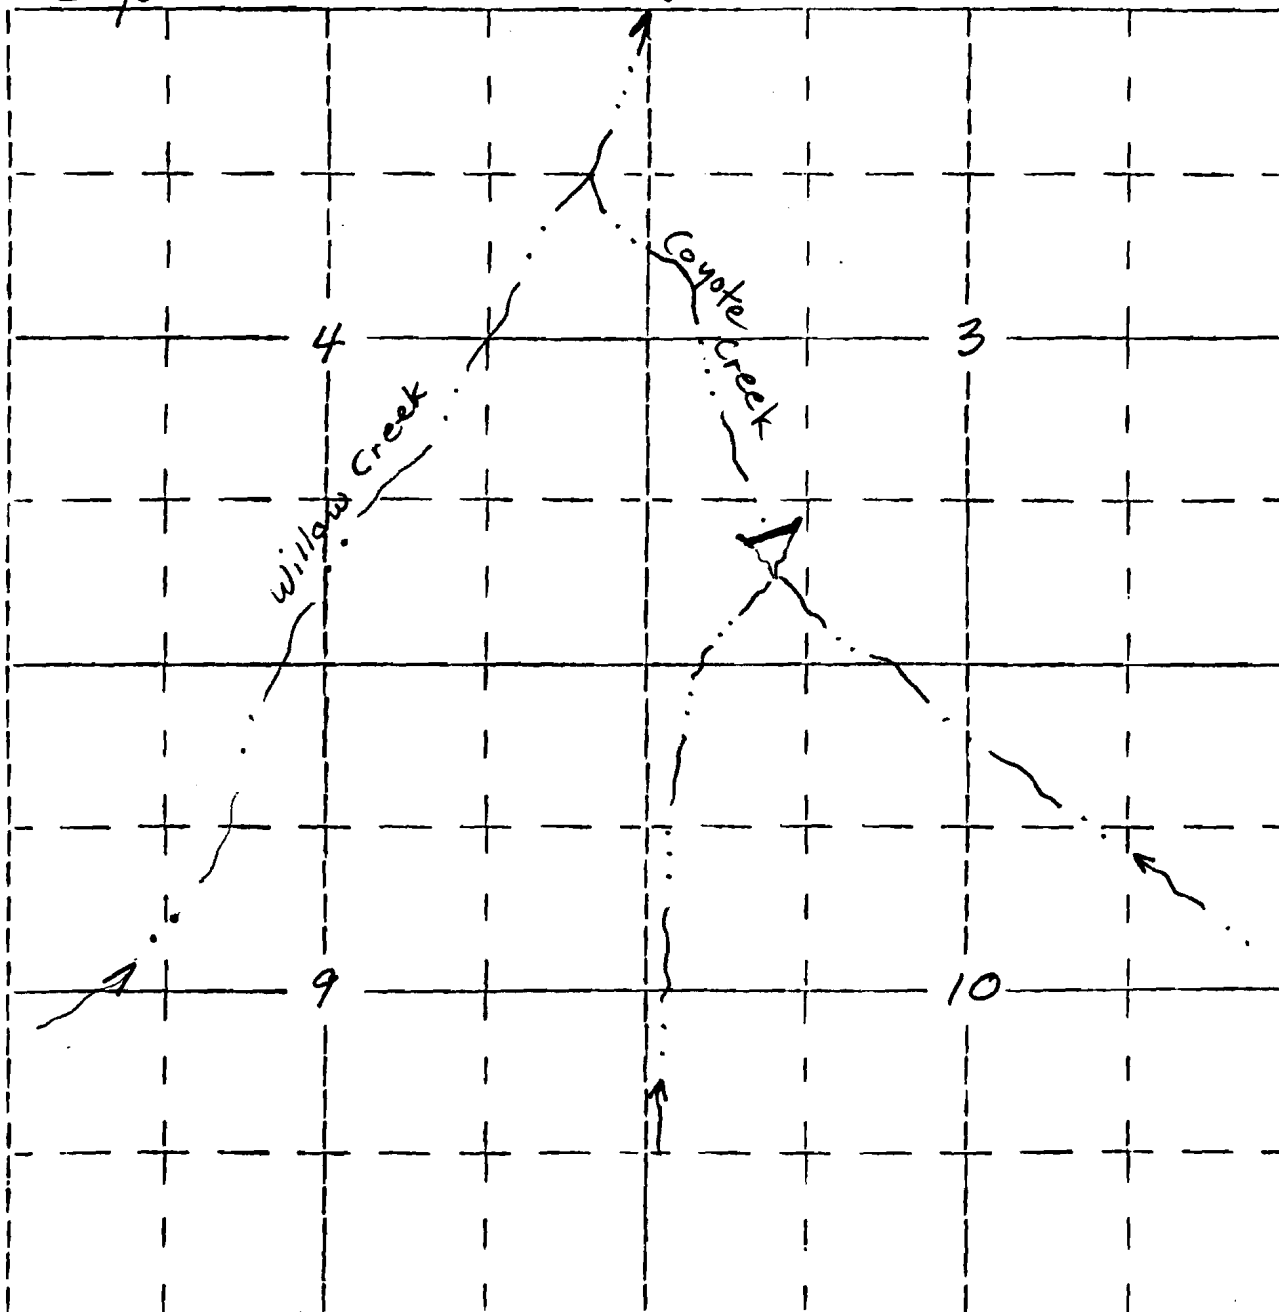

1210' N., 1210' E of SW Corner, section 3

RECEIVED
OCT 14 1983
WATER RESOURCES DEPT.
SALEM, OREGON