

R 9599
78716

Form OR-010-7300-2
4/83

UNITED STATES
DEPARTMENT OF THE INTERIOR
BUREAU OF LAND MANAGEMENT


Section 21
SW SW

Township 28 south
Range 13 east

Appl. No. R-67791

Permit No. R 9599

Timothy Creek Res. (5262)

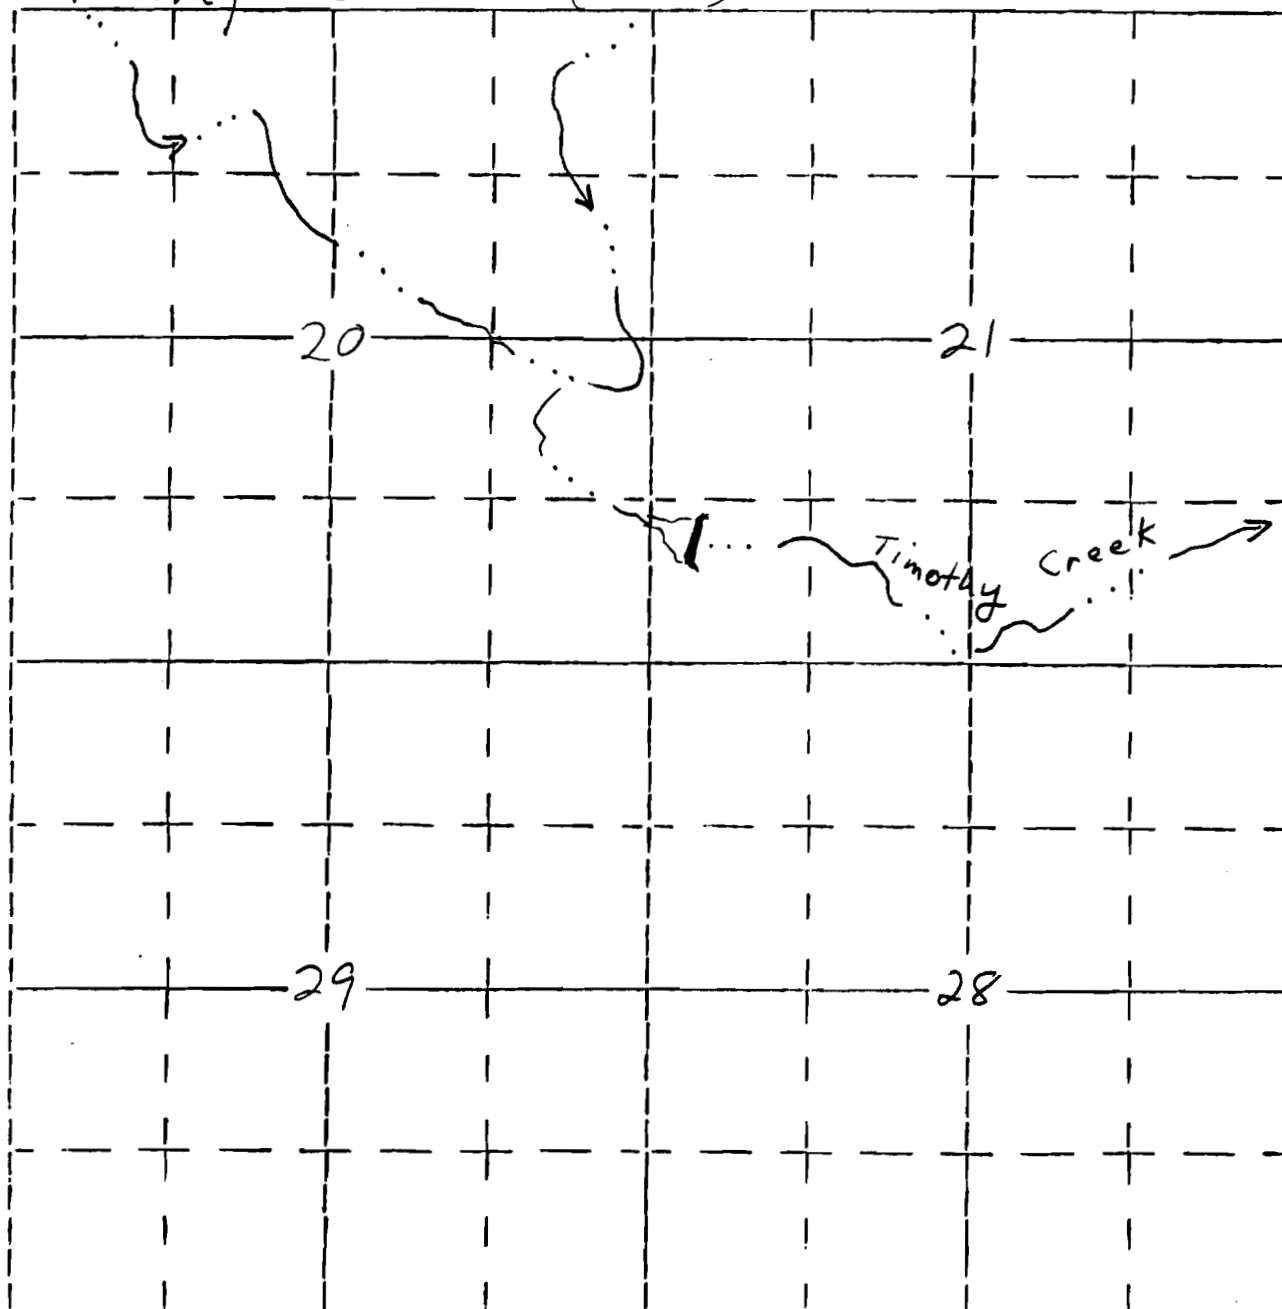

1135' N., 385' E., of SW Corner, sec. 21

RECEIVED

OCT 14 1983

WATER RESOURCES DEPT.
SALEM, OREGON