

R9828
78717

Form OR-010-7300-2
4/83

UNITED STATES
DEPARTMENT OF THE INTERIOR
BUREAU OF LAND MANAGEMENT

Section

10

Township 39 S.

Appl. No. R-66091


Range 23 E.

Permit No. R 9828

Will. Mer.

DEERFLY RESERVOIR No. 5398

RECORDED
SEP 15 1933
WATER RESOURCES DEPT.
SALEM, OREGON

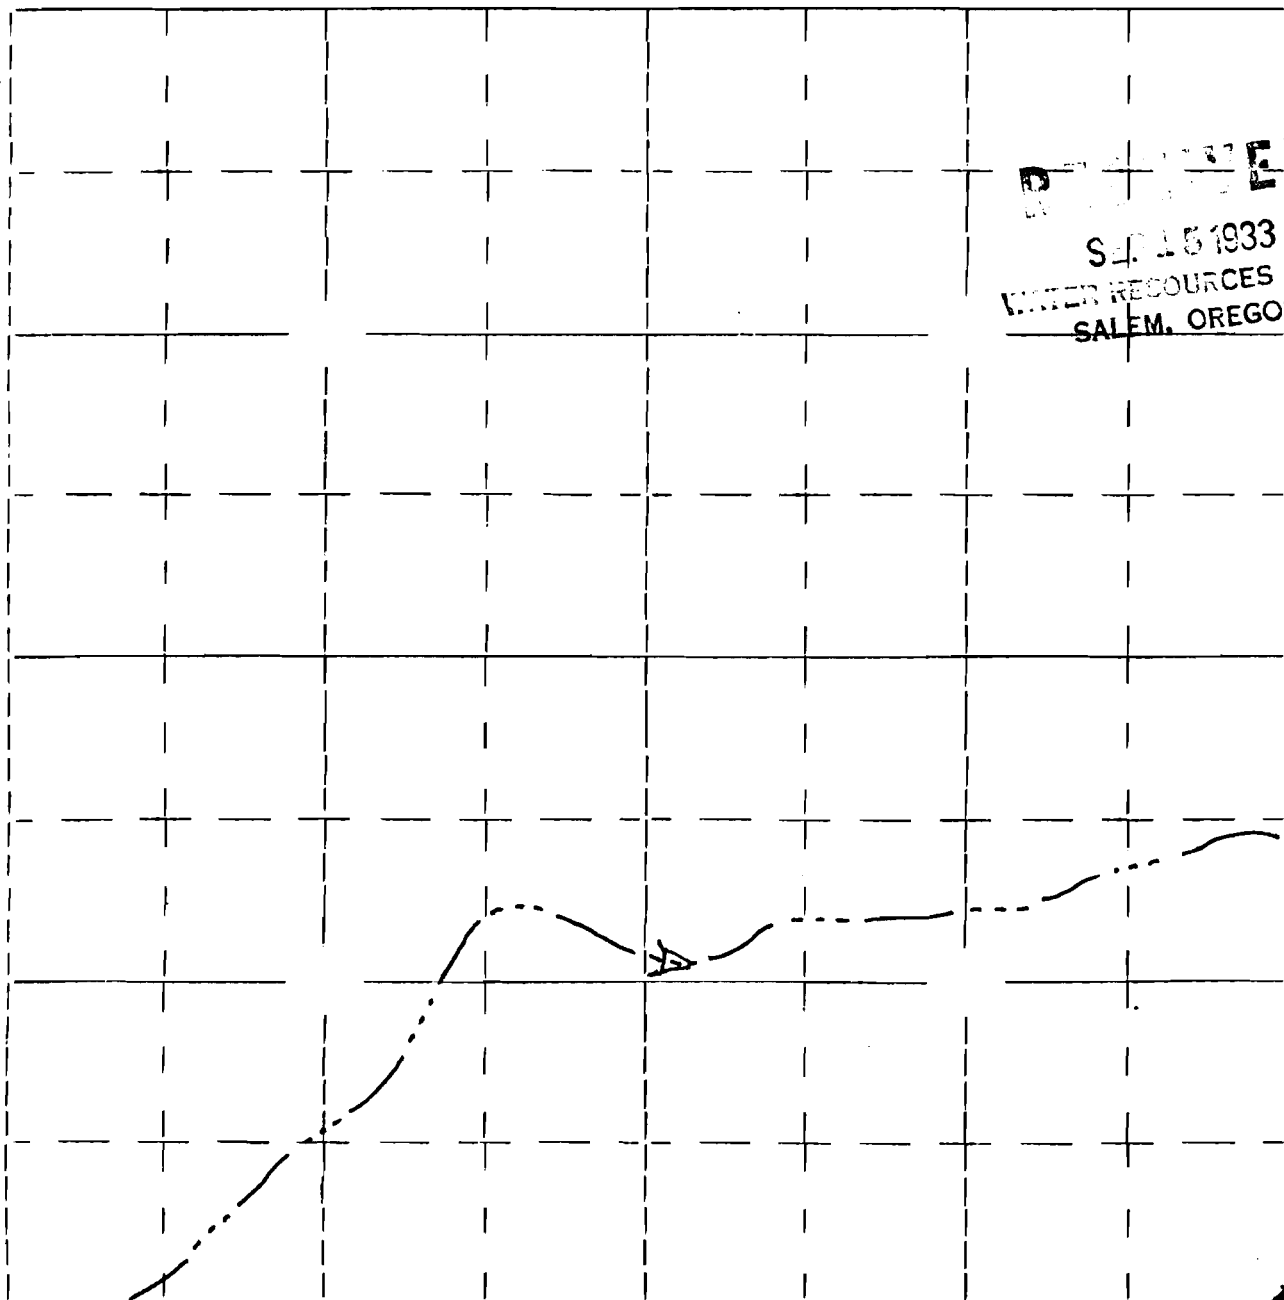

DAM IS LOCATED 1330 FEET NORTH AND 2570 FEET WEST
OF THE CORNER COMMON TO SECTIONS 10, 11, 14 AND 15