

29840
78719

Form OR-010-7300-2
4/83

UNITED STATES
DEPARTMENT OF THE INTERIOR
BUREAU OF LAND MANAGEMENT

Section

8

T 395

R 23E

Woodpecker
(5399)


Appl. No. R-67113

Permit No. R 9840

RECEIVED

OCT 31 1983
WATER RESOURCES DEPT.
SALEM, OREGON

8

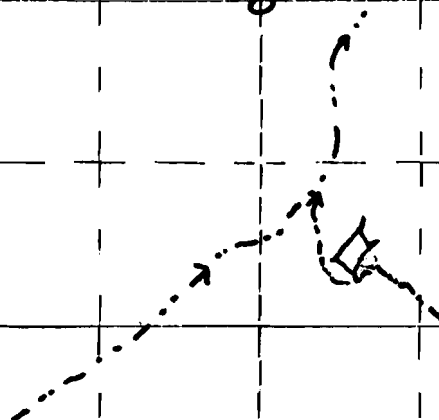

1600' North and 2280' West
of the SE Corner of Sec. 8