

R9849
78721

Form OR-010-7300-2
4/83

UNITED STATES
DEPARTMENT OF THE INTERIOR
BUREAU OF LAND MANAGEMENT

Section

10

Township 41S.


Appl. No. R-66093

Range 23E.

Permit No. R 9849

Will. Mer.

DEEP RESERVOIR No. 5403

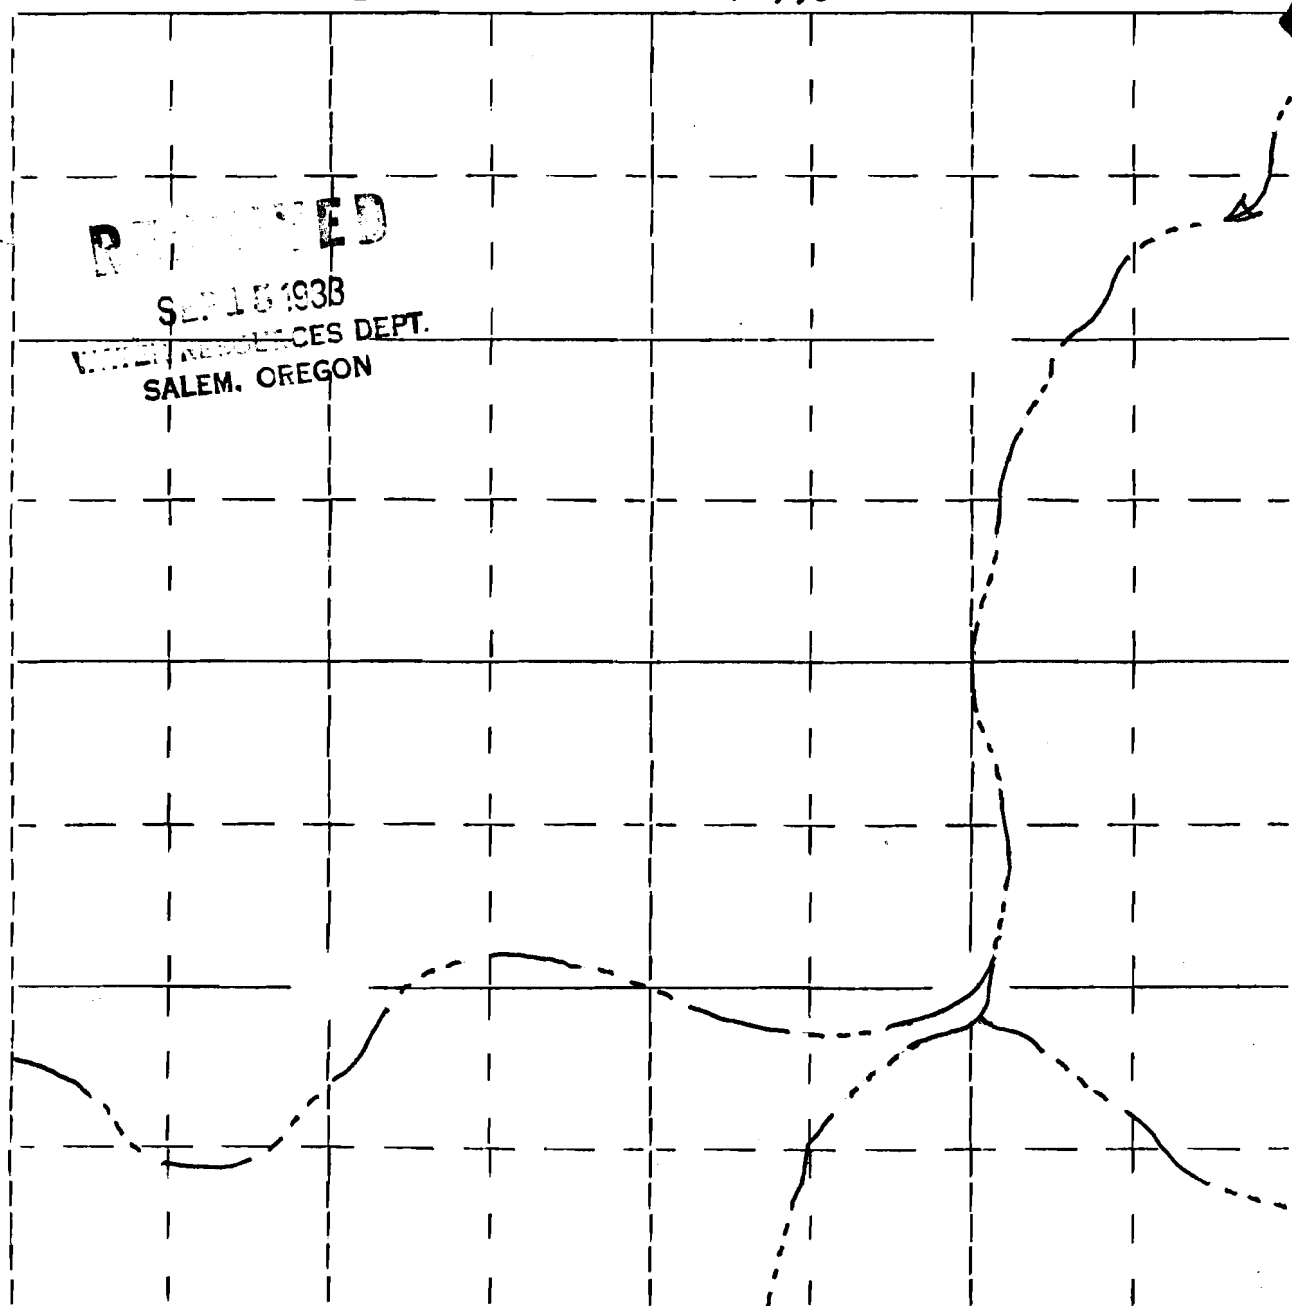

*DAM IS LOCATED 760 FEET SOUTH AND 225 FEET WEST
OF THE CORNER COMMON TO SECTIONS 2, 3, 10 AND 11*