

R10028
78723

Form OR-010-7300-2
4/83

UNITED STATES
DEPARTMENT OF THE INTERIOR
BUREAU OF LAND MANAGEMENT


Section 11
NESW

Township 32S
Range 27E

Appl. No. R-67369
Permit No. R10028

Will. Mer.

Chrome Reservoir (#1331)

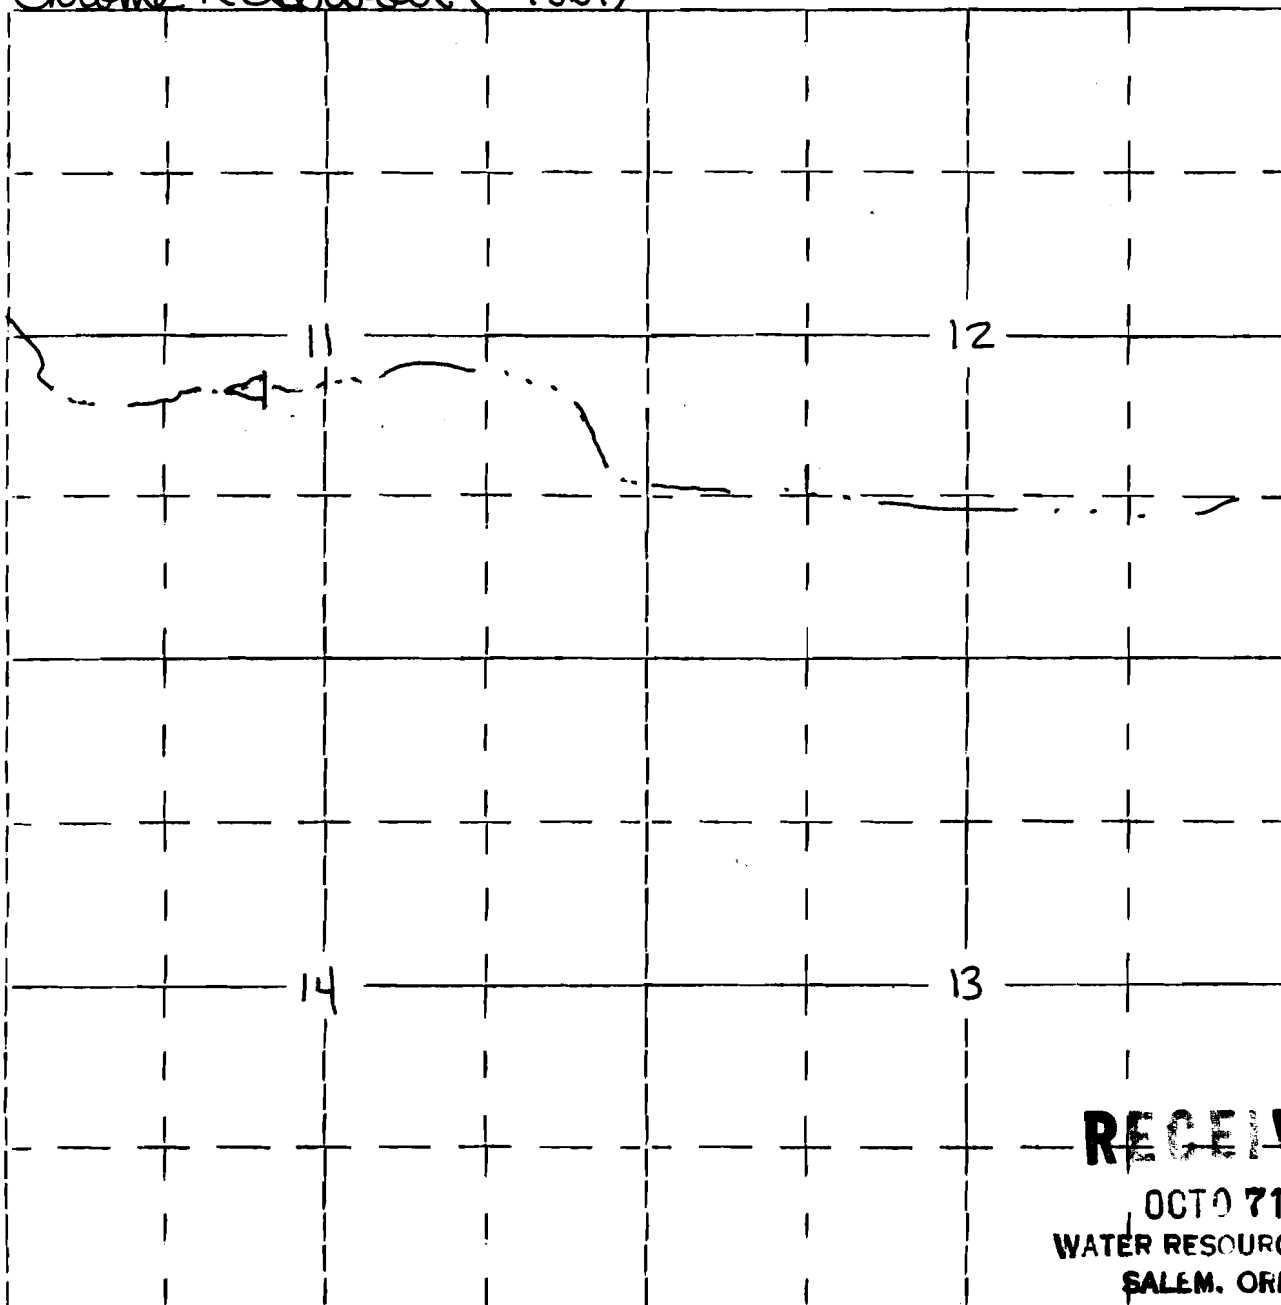

RECEIVED

OCT 7 1983
WATER RESOURCES DEPT.
SALEM, OREGON

1900' N 2400' E of SW corner of section 11