

Form OR-010-7300-2
4/83

UNITED STATES
DEPARTMENT OF THE INTERIOR
BUREAU OF LAND MANAGEMENT

Section

17

Township 39 south

Appl. No. R-66282


SESE

Range 25 east

Permit No. R10567

Will. Mer.

Bottle Reservoir #0715

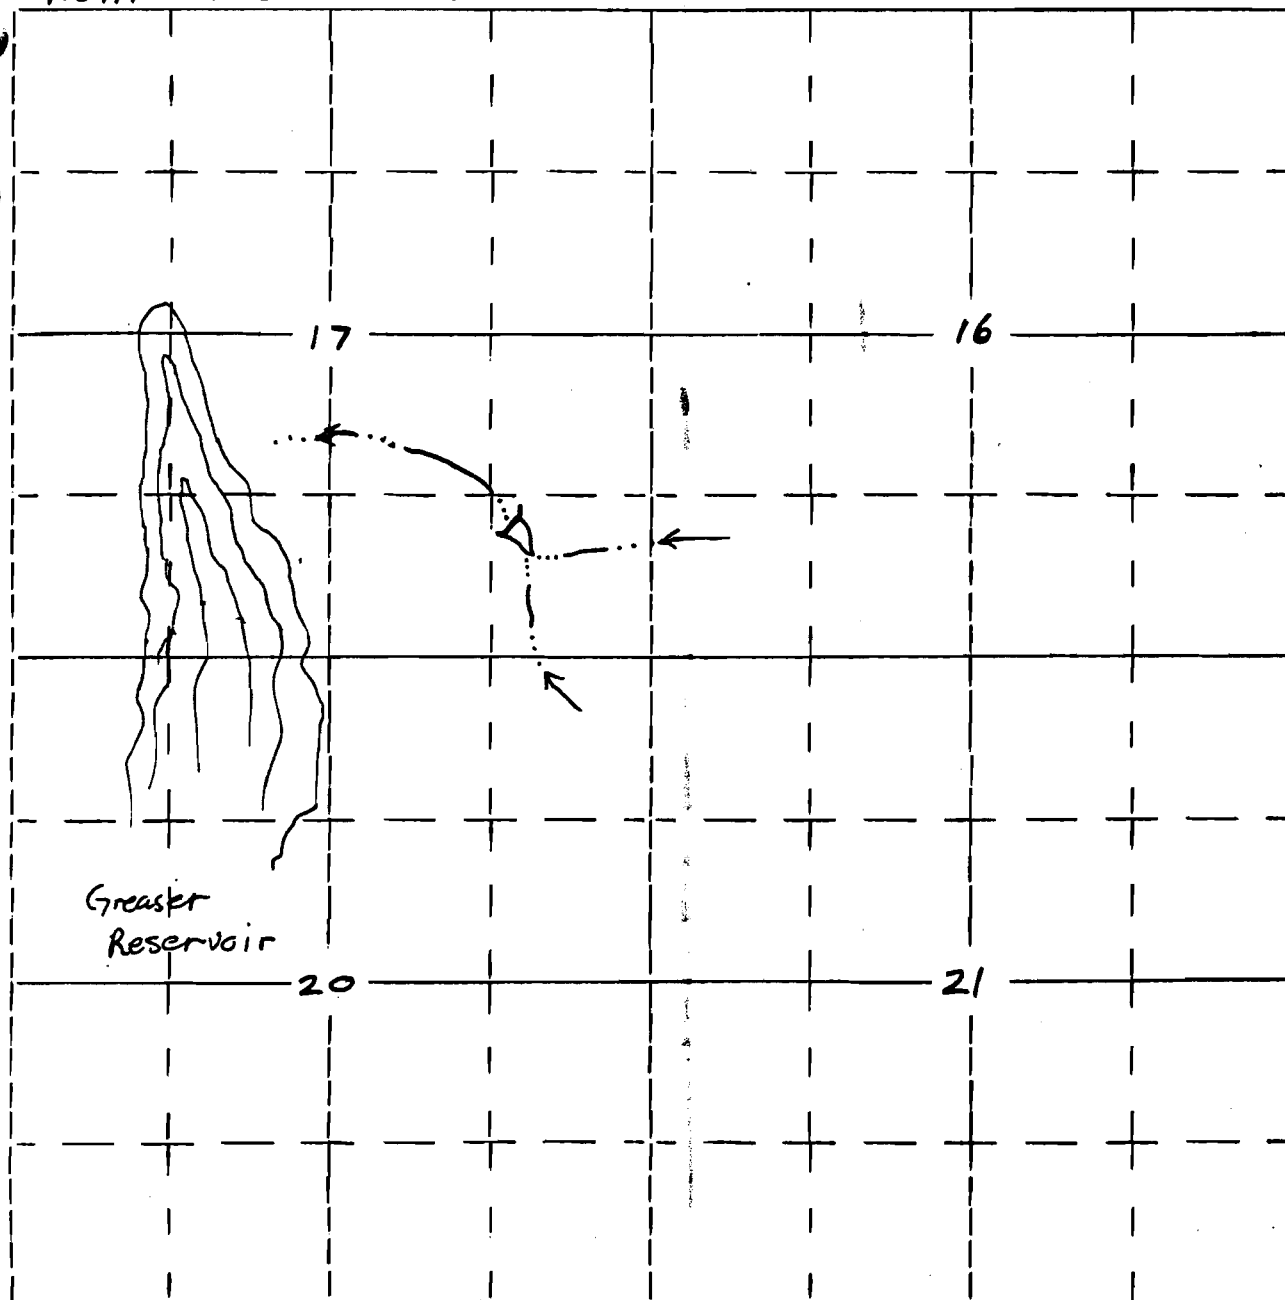

1050' North, 1150' West of SE Corner of section 17