

Form OR-010-7300-2
4/83


UNITED STATES
DEPARTMENT OF THE INTERIOR
BUREAU OF LAND MANAGEMENT

Section

18 NENE
T 36S
R 29E

North Spring
(5516)

Appl. No. R-66288
Permit No. **R10573**

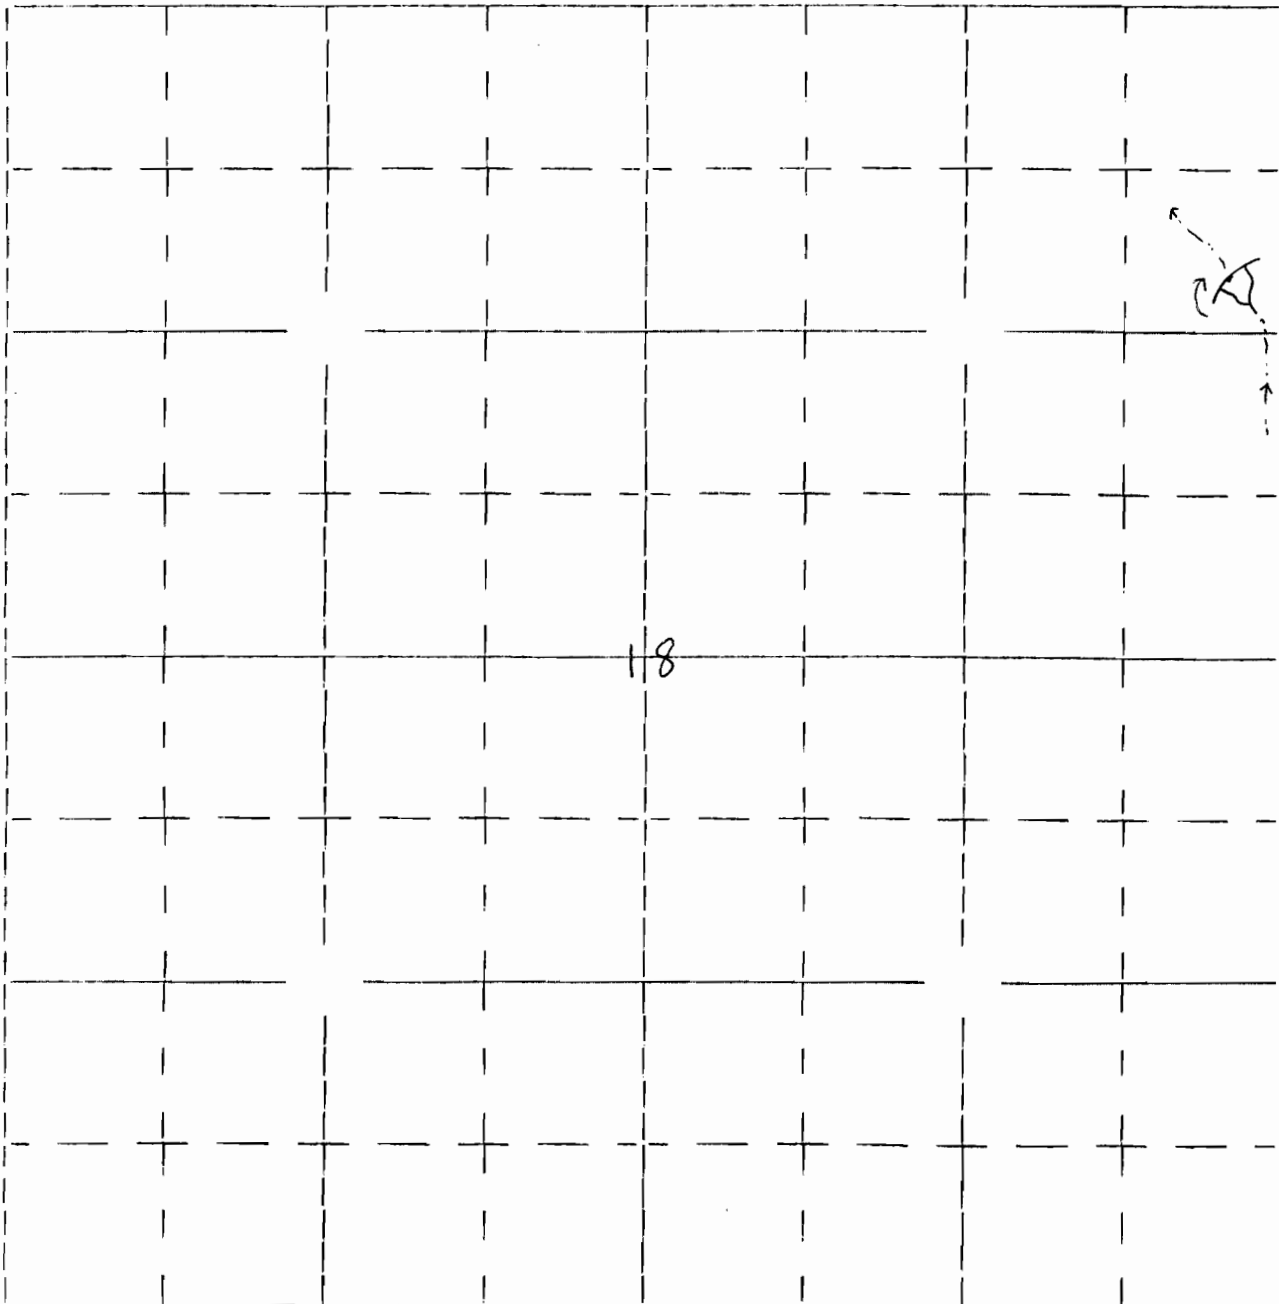

4090' North and 235' West
of the SE Corner of Sec 18