

Form OR-010-7300-2  
4/83

UNITED STATES  
DEPARTMENT OF THE INTERIOR  
BUREAU OF LAND MANAGEMENT

Section

10 NESE


T38S

R28E

*Horse trap*  
*(5520)*

Appl. No. R-66289

Permit No. **R10574**

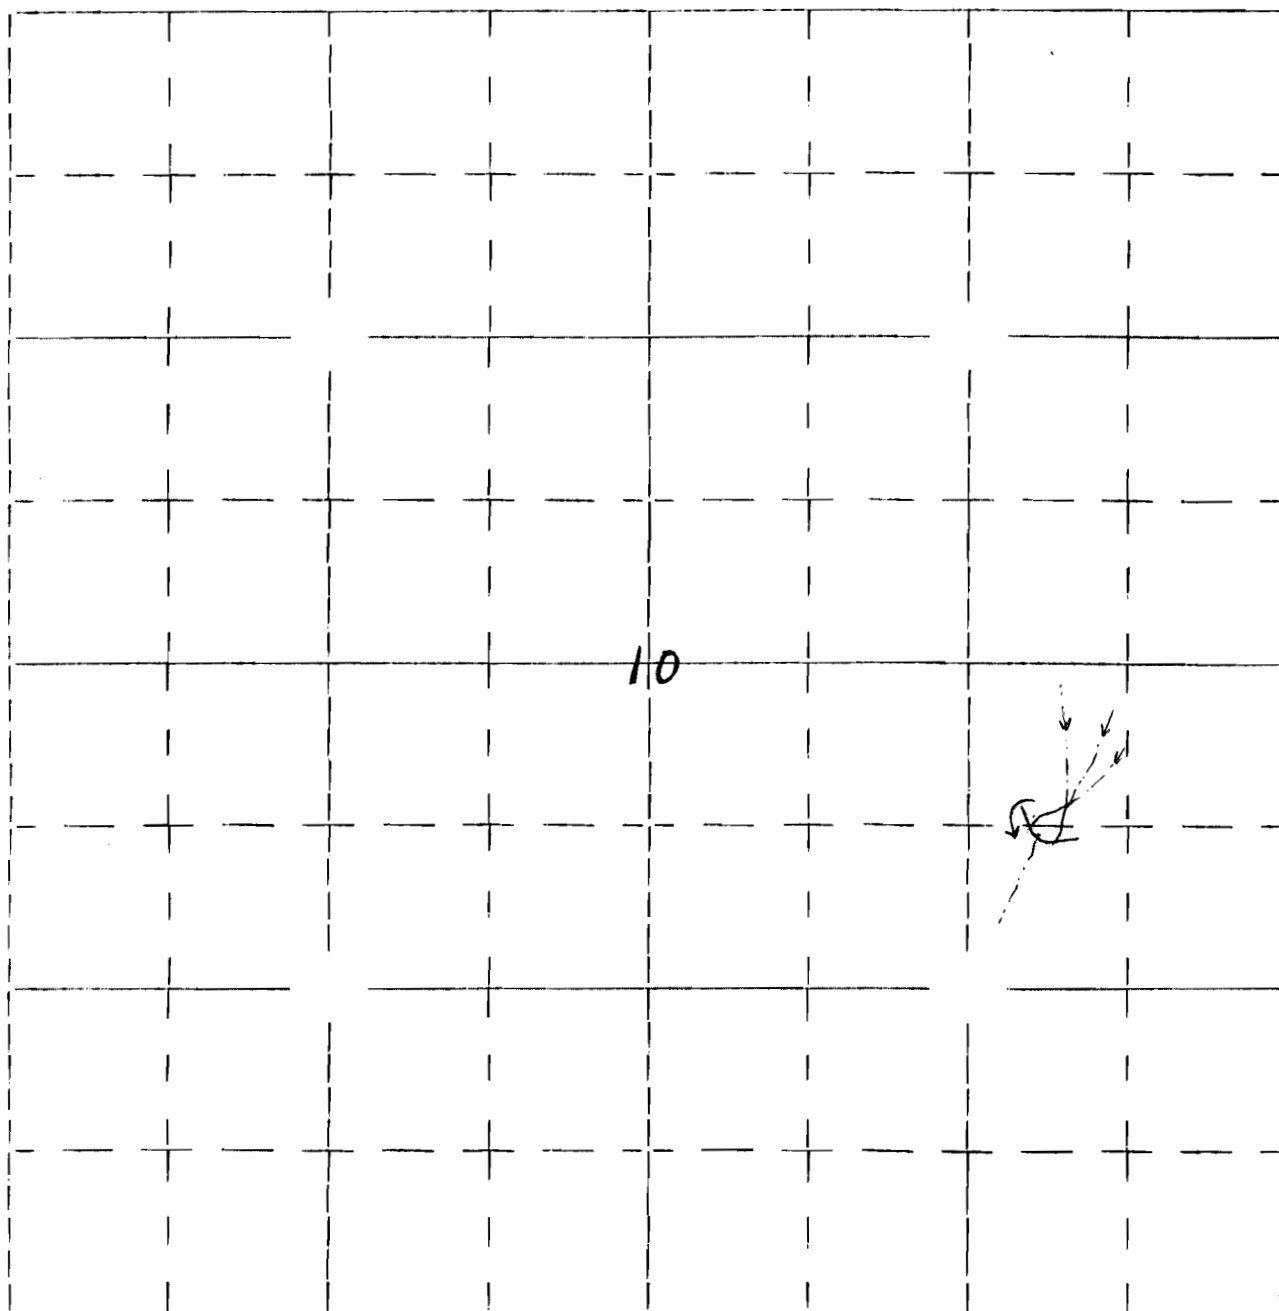

*1950' North and 1000' West  
of the SE Corner of Sec. 10*