

Form OR-010-7300-2
4/83


UNITED STATES
DEPARTMENT OF THE INTERIOR
BUREAU OF LAND MANAGEMENT

Section

10 NESW
T38S
R27E

Hitching Post
(5508)

Appl. No. R-66291
Permit No. **R10576**

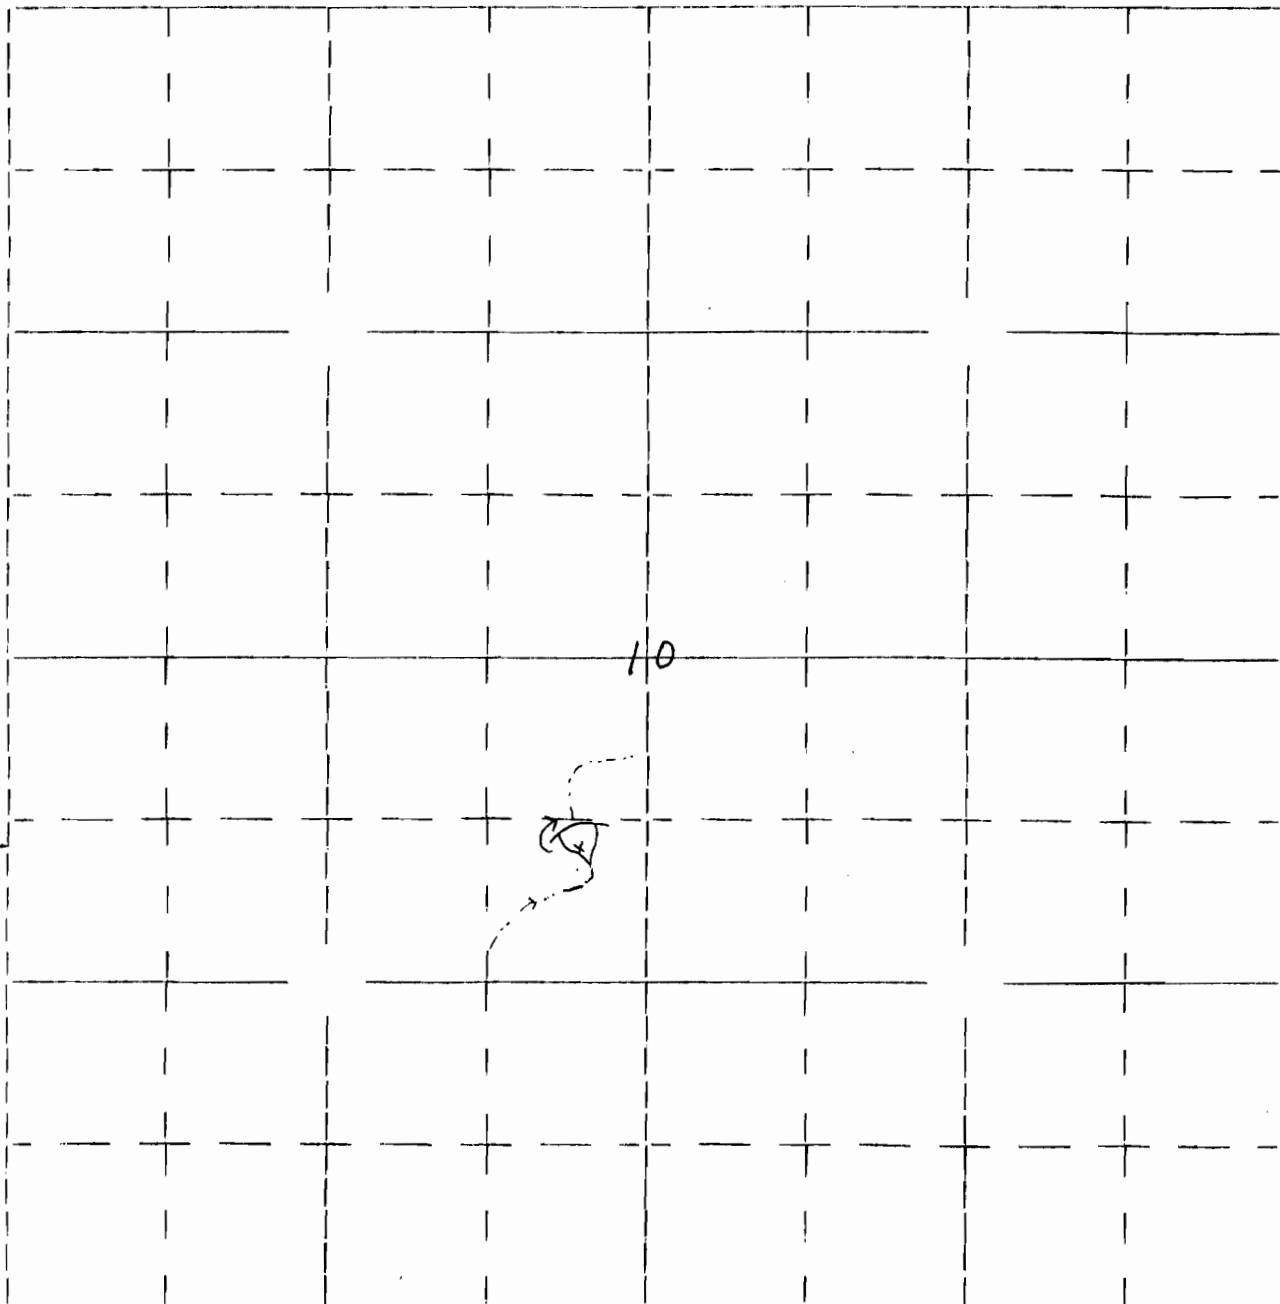

1880' north and 2280' East
of the SW corner of Sec. 10