

Form OR-010-7300-2
4/83


UNITED STATES
DEPARTMENT OF THE INTERIOR
BUREAU OF LAND MANAGEMENT

Section

2 NWSW
T38S
R26E

upper clover swale
(5052)

Appl. No. R-66293
Permit No. R10577

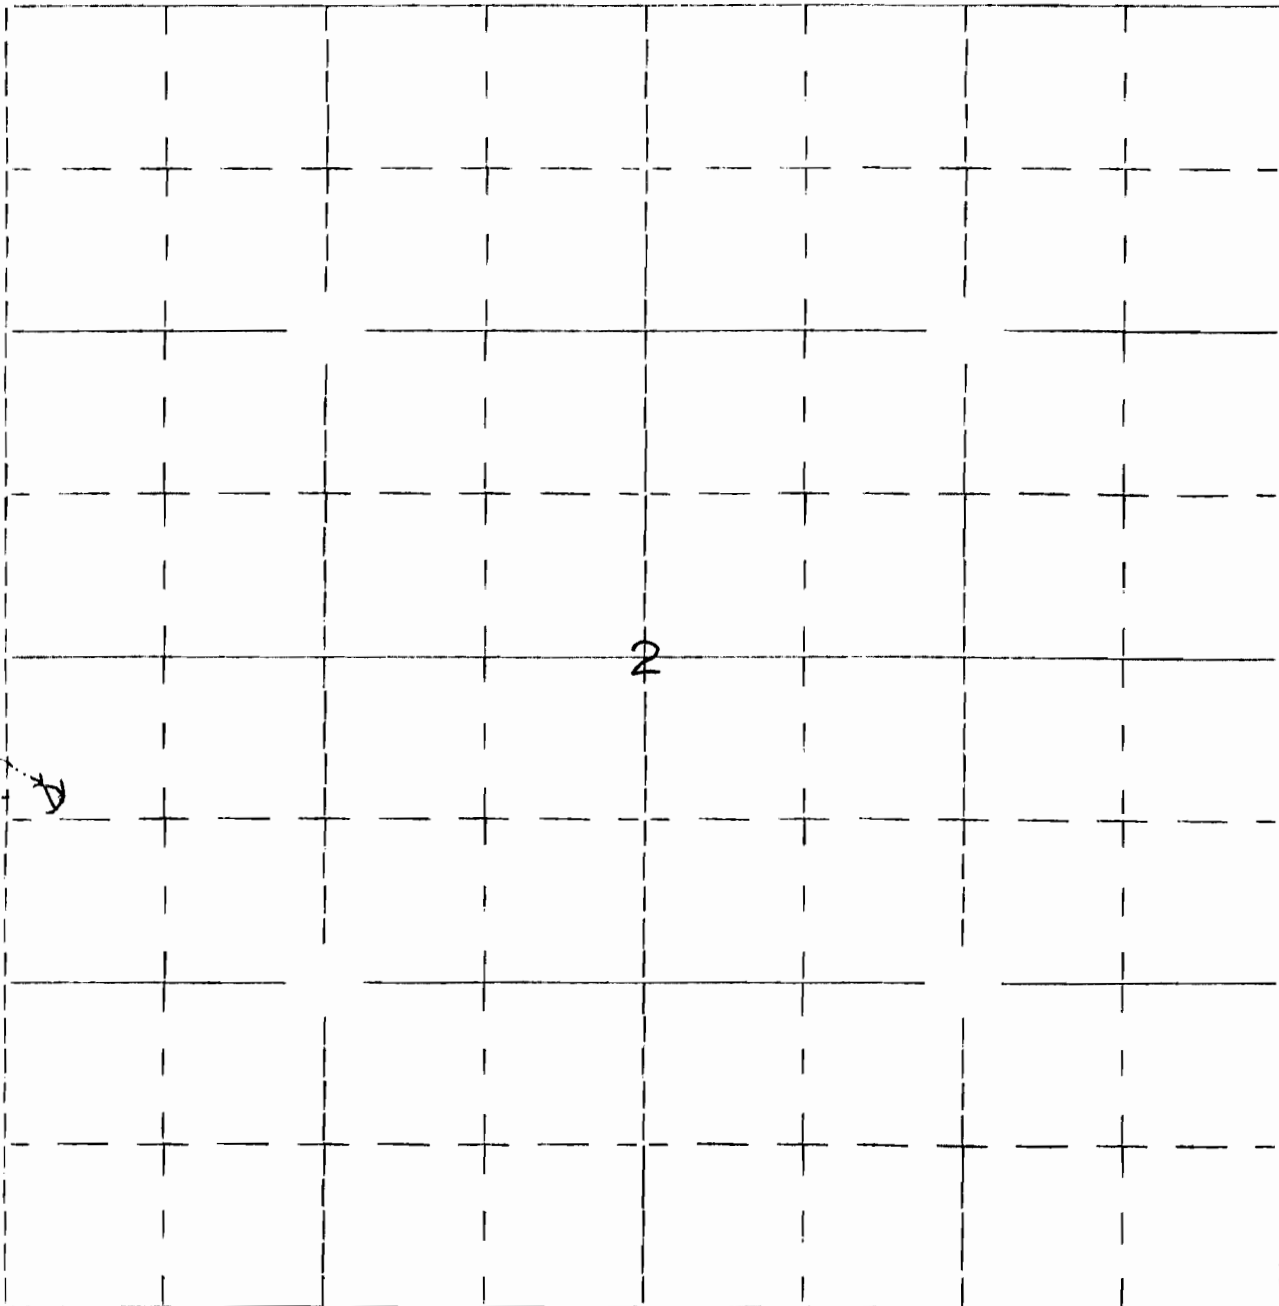

2040' North and 200' East of the SW corner
of Section 2.