


STATE ENGINEER
RECEIVED

MAR 15 1926

SALEM. OREGON

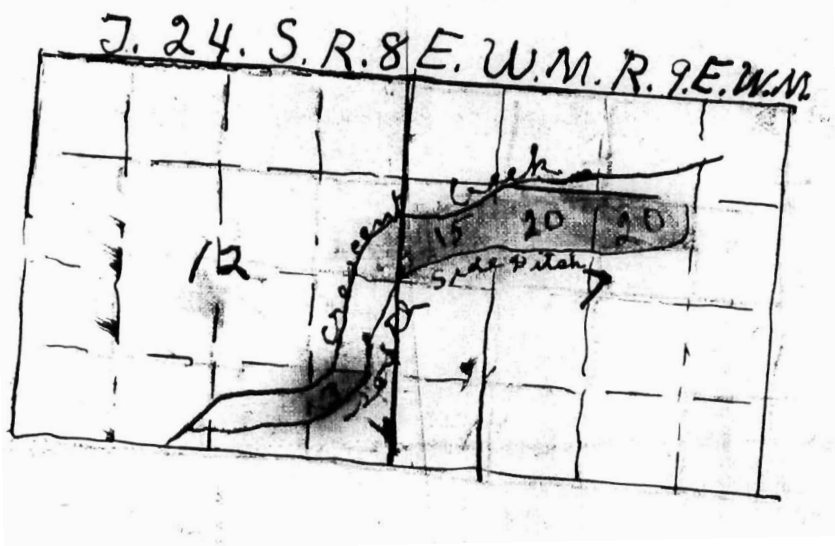

Application No. 10043
Permit No. 7232

C7873

7232