

n OR-010-7300-2
4/83

UNITED STATES
DEPARTMENT OF THE INTERIOR
BUREAU OF LAND MANAGEMENT

Section

25

Township 39S

Appl. No. R-66301


NE SW

Range 23E

Permit No. R10585

Will. Mer.

Ditch Res #4240

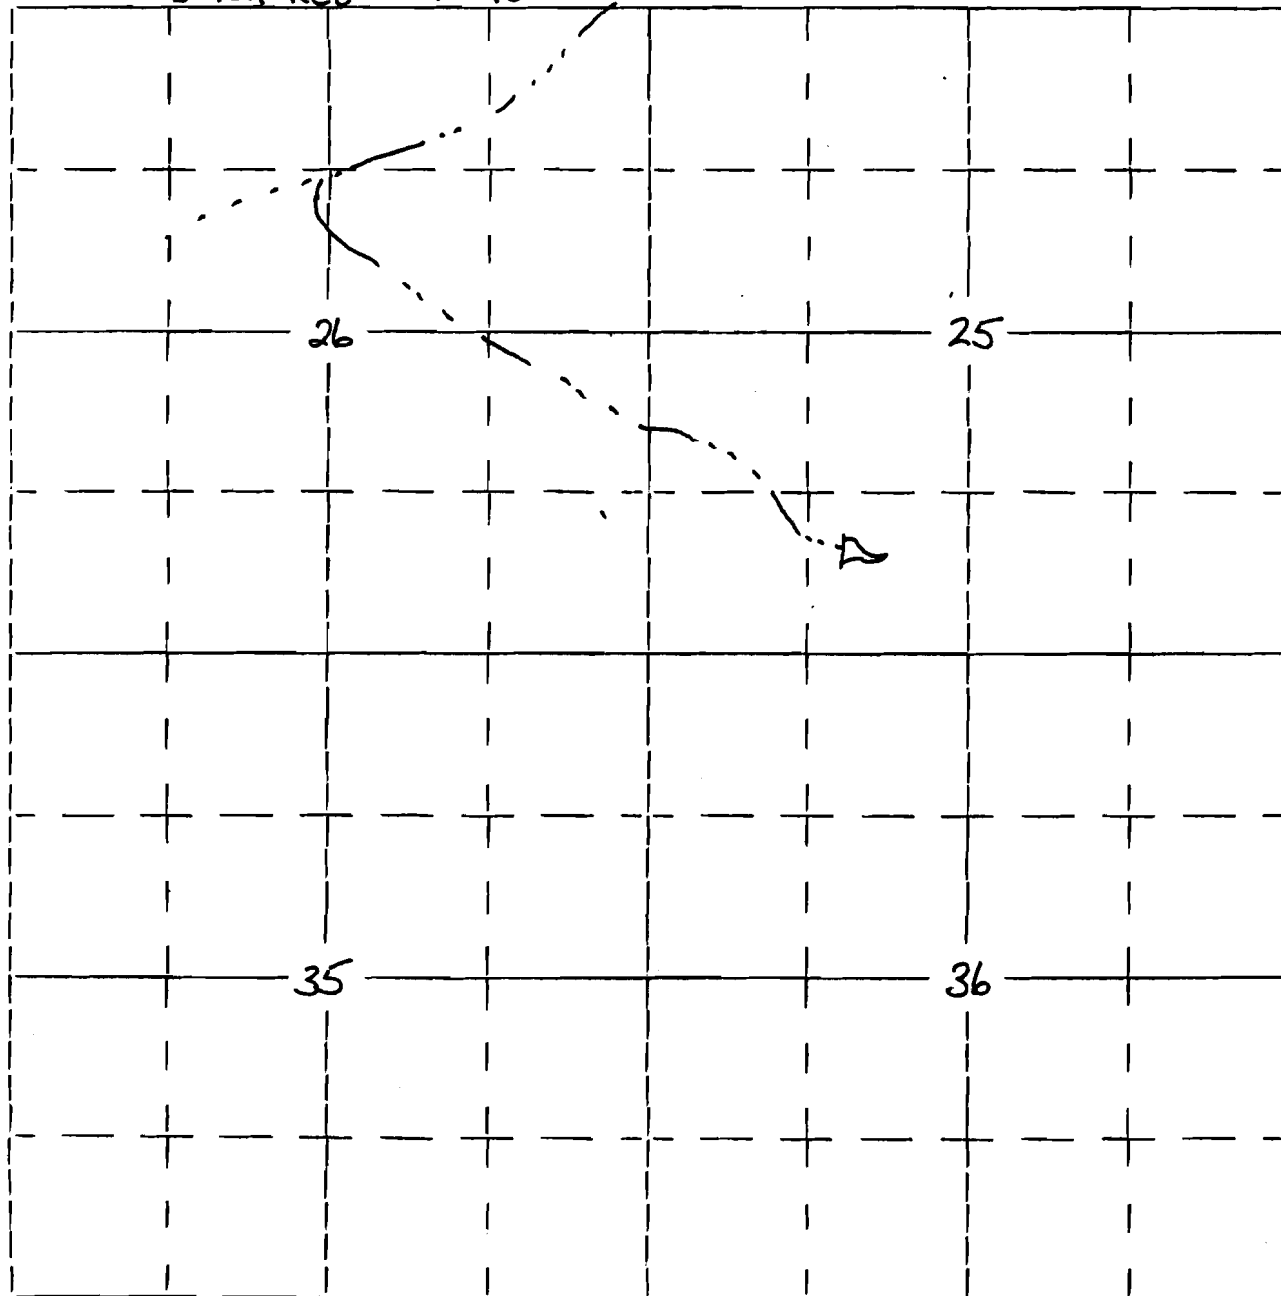

500 'N, 1700 'E, of S.E. corner section 25