

R-11822

RECEIVED 78731

MAY 8 1954


Form OR-010-7300-2
4/83UNITED STATES
DEPARTMENT OF THE INTERIOR
BUREAU OF LAND MANAGEMENTWATER RESOURCES DEPT
SALEM, OREGON

Section

28Township 39SAppl. No. R67625NWSERange 23EPermit No. R11822

Will. Mer.

Big Reservoir 1132

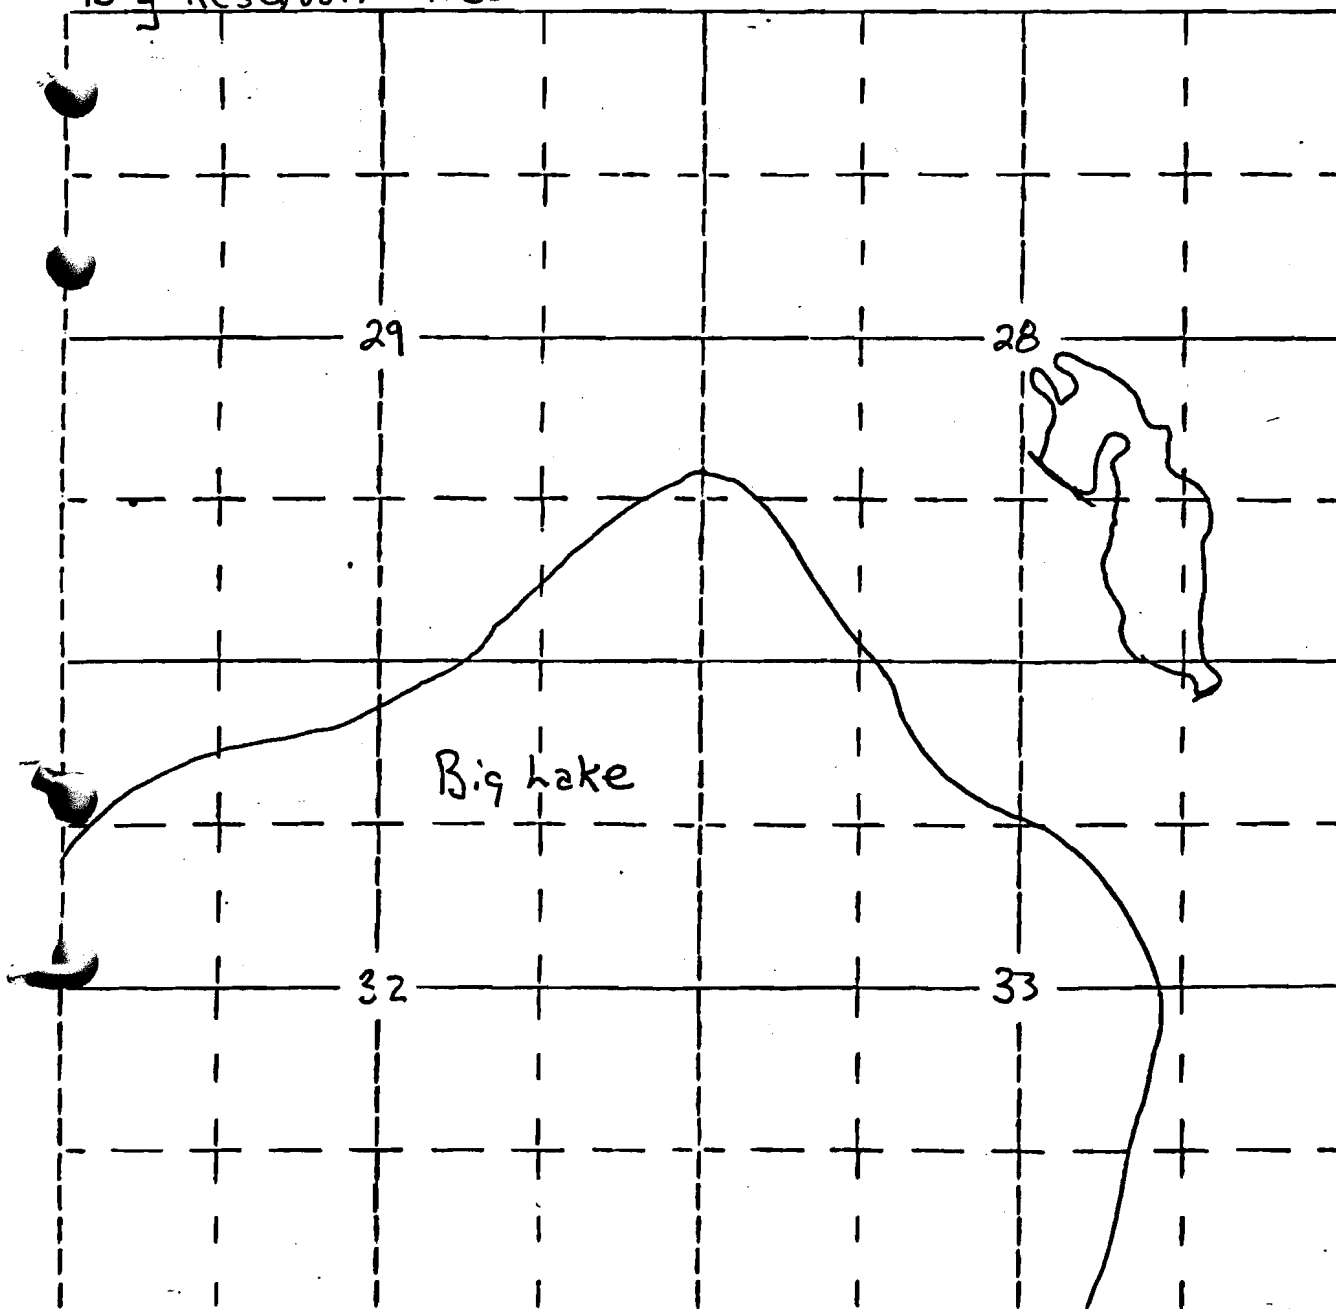

1500' N 2250' W of the SE Corner of section 28