

R-11902
78732

RECEIVED

MAY 8 1984

Form OR-010-7300-2
4/83

UNITED STATES
DEPARTMENT OF THE INTERIOR
BUREAU OF LAND MANAGEMENT

WATER RESOURCES DEPT
SALEM, OREGON


Section 3
NESW

Township 39S
Range 26E

Appl. No. R67621
Permit No. R11902

Will. Mer.

Long Lake Diversion Dam #0844

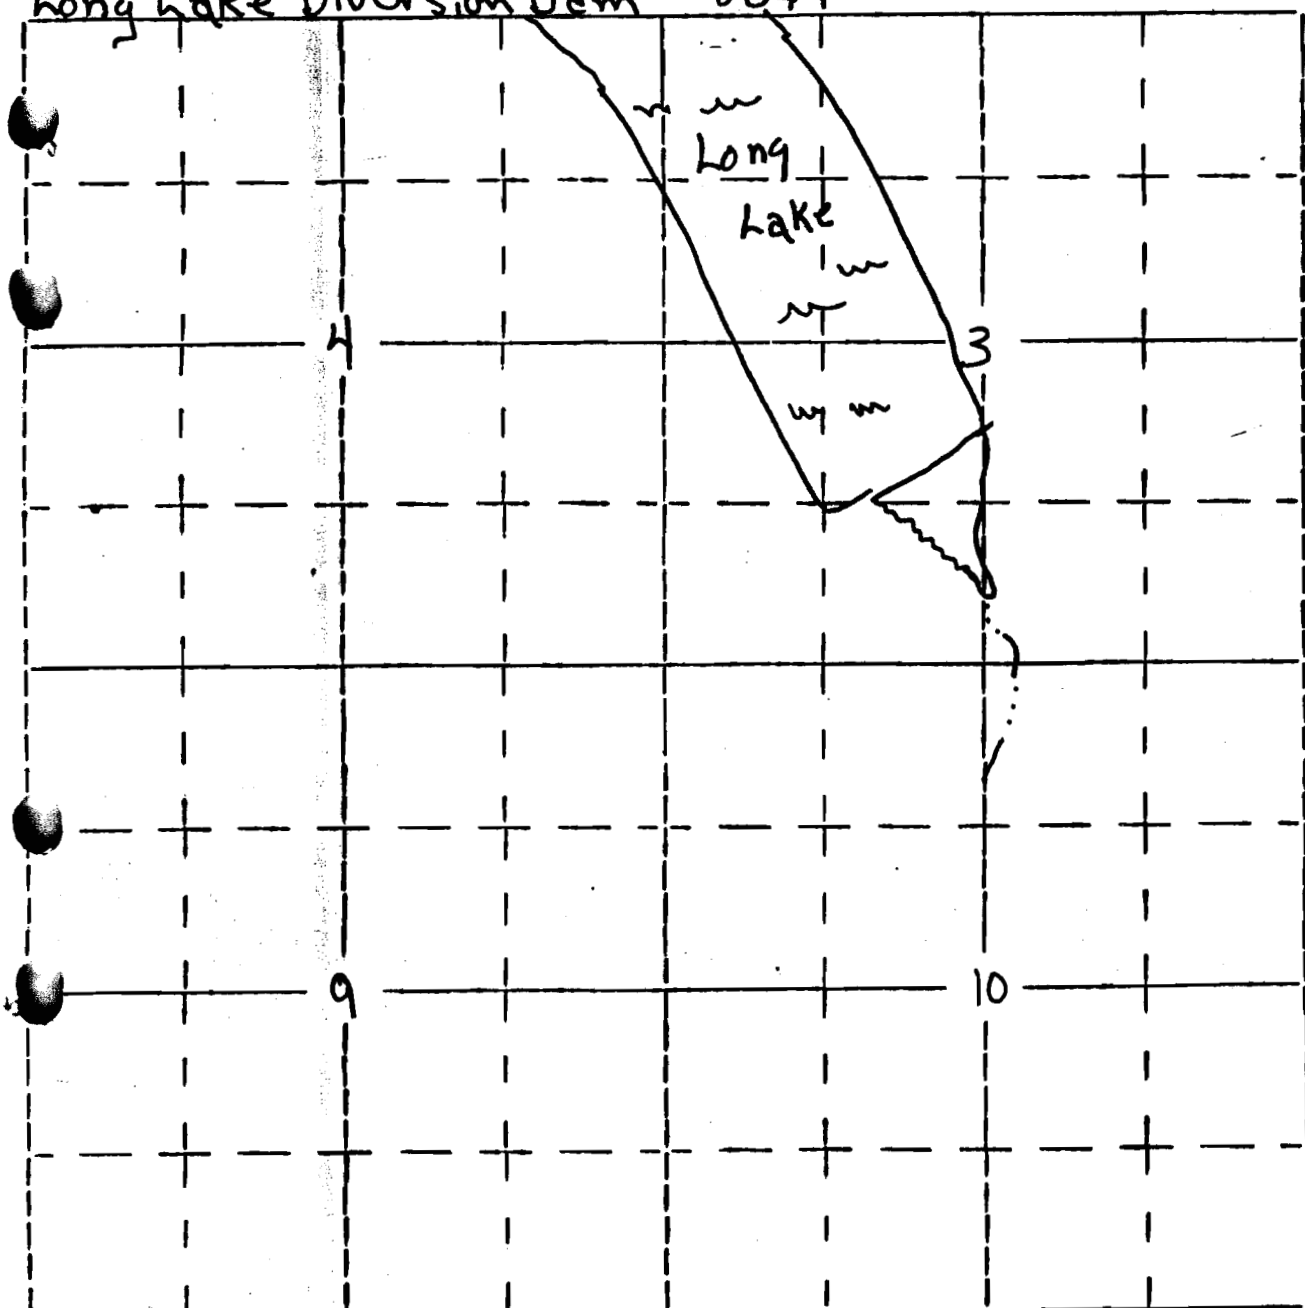

1600' N 2000' E of the SW corner of section 3