


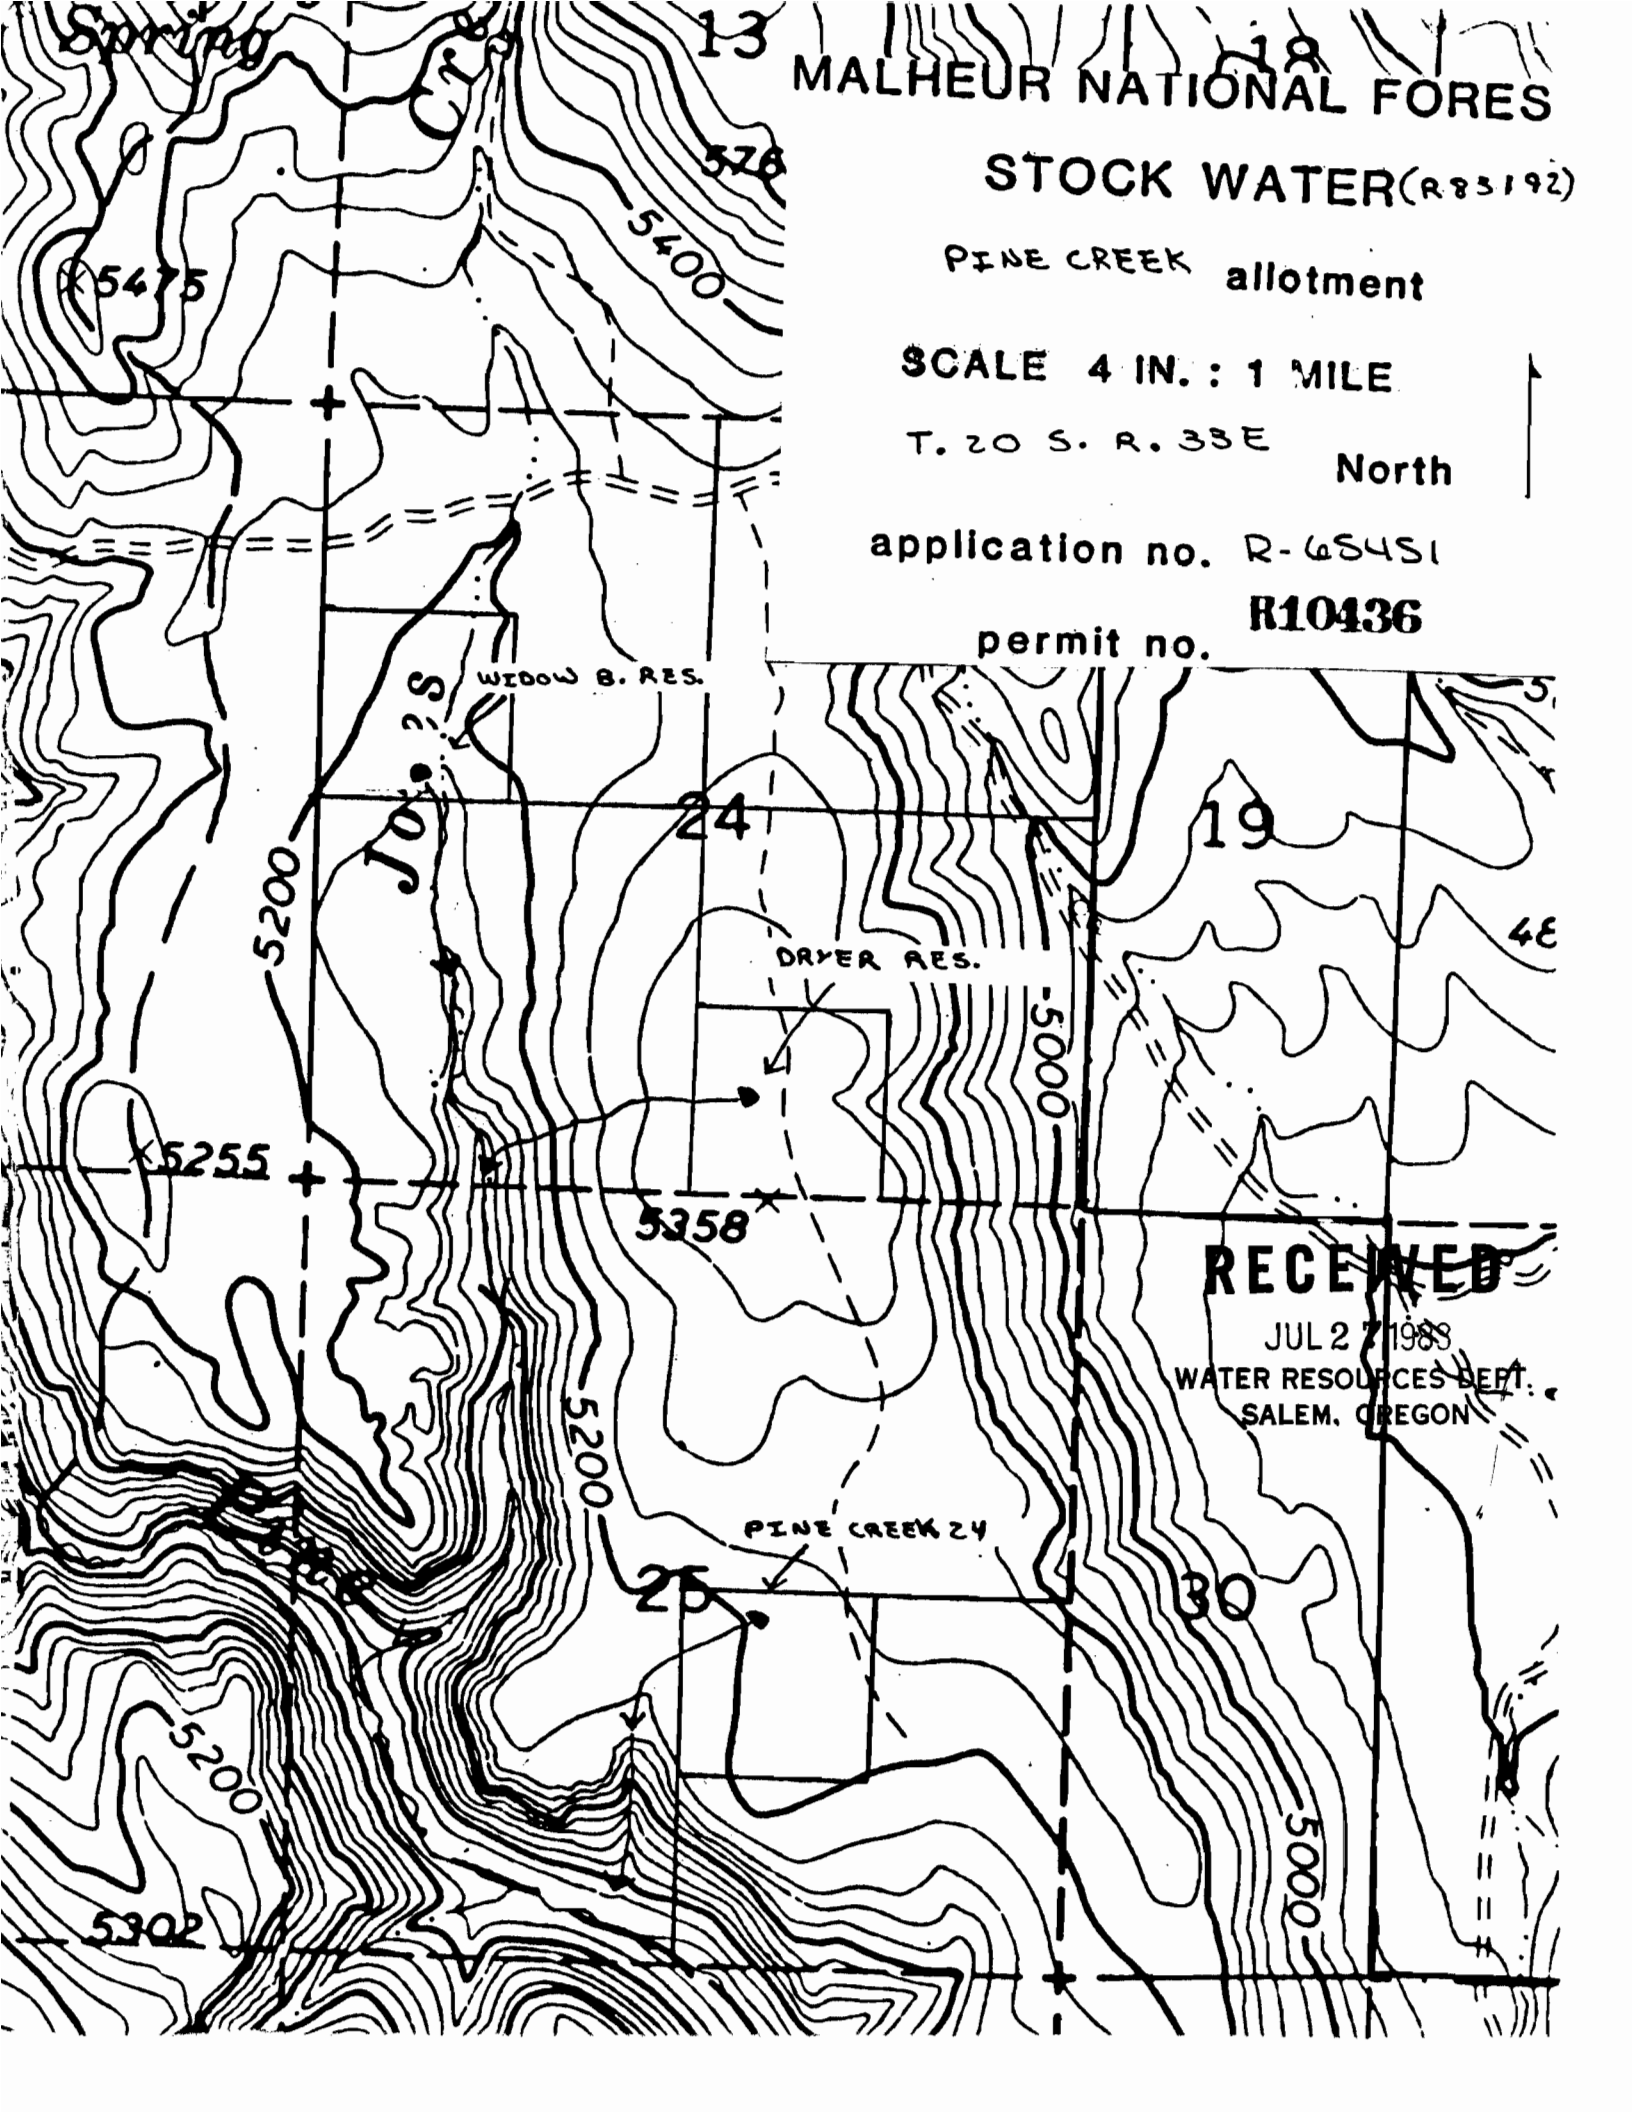

MALHEUR NATIONAL FORES

STOCK WATER (R83192)

PINE CREEK allotment

SCALE 4 IN. : 1 MILE

T. 20 S. R. 33 E North

application no. R-65451

permit no. R10436

RECEIVED

JUL 27 1988

WATER RESOURCES DEPT.
SALEM, OREGON