


SECTION

6

North

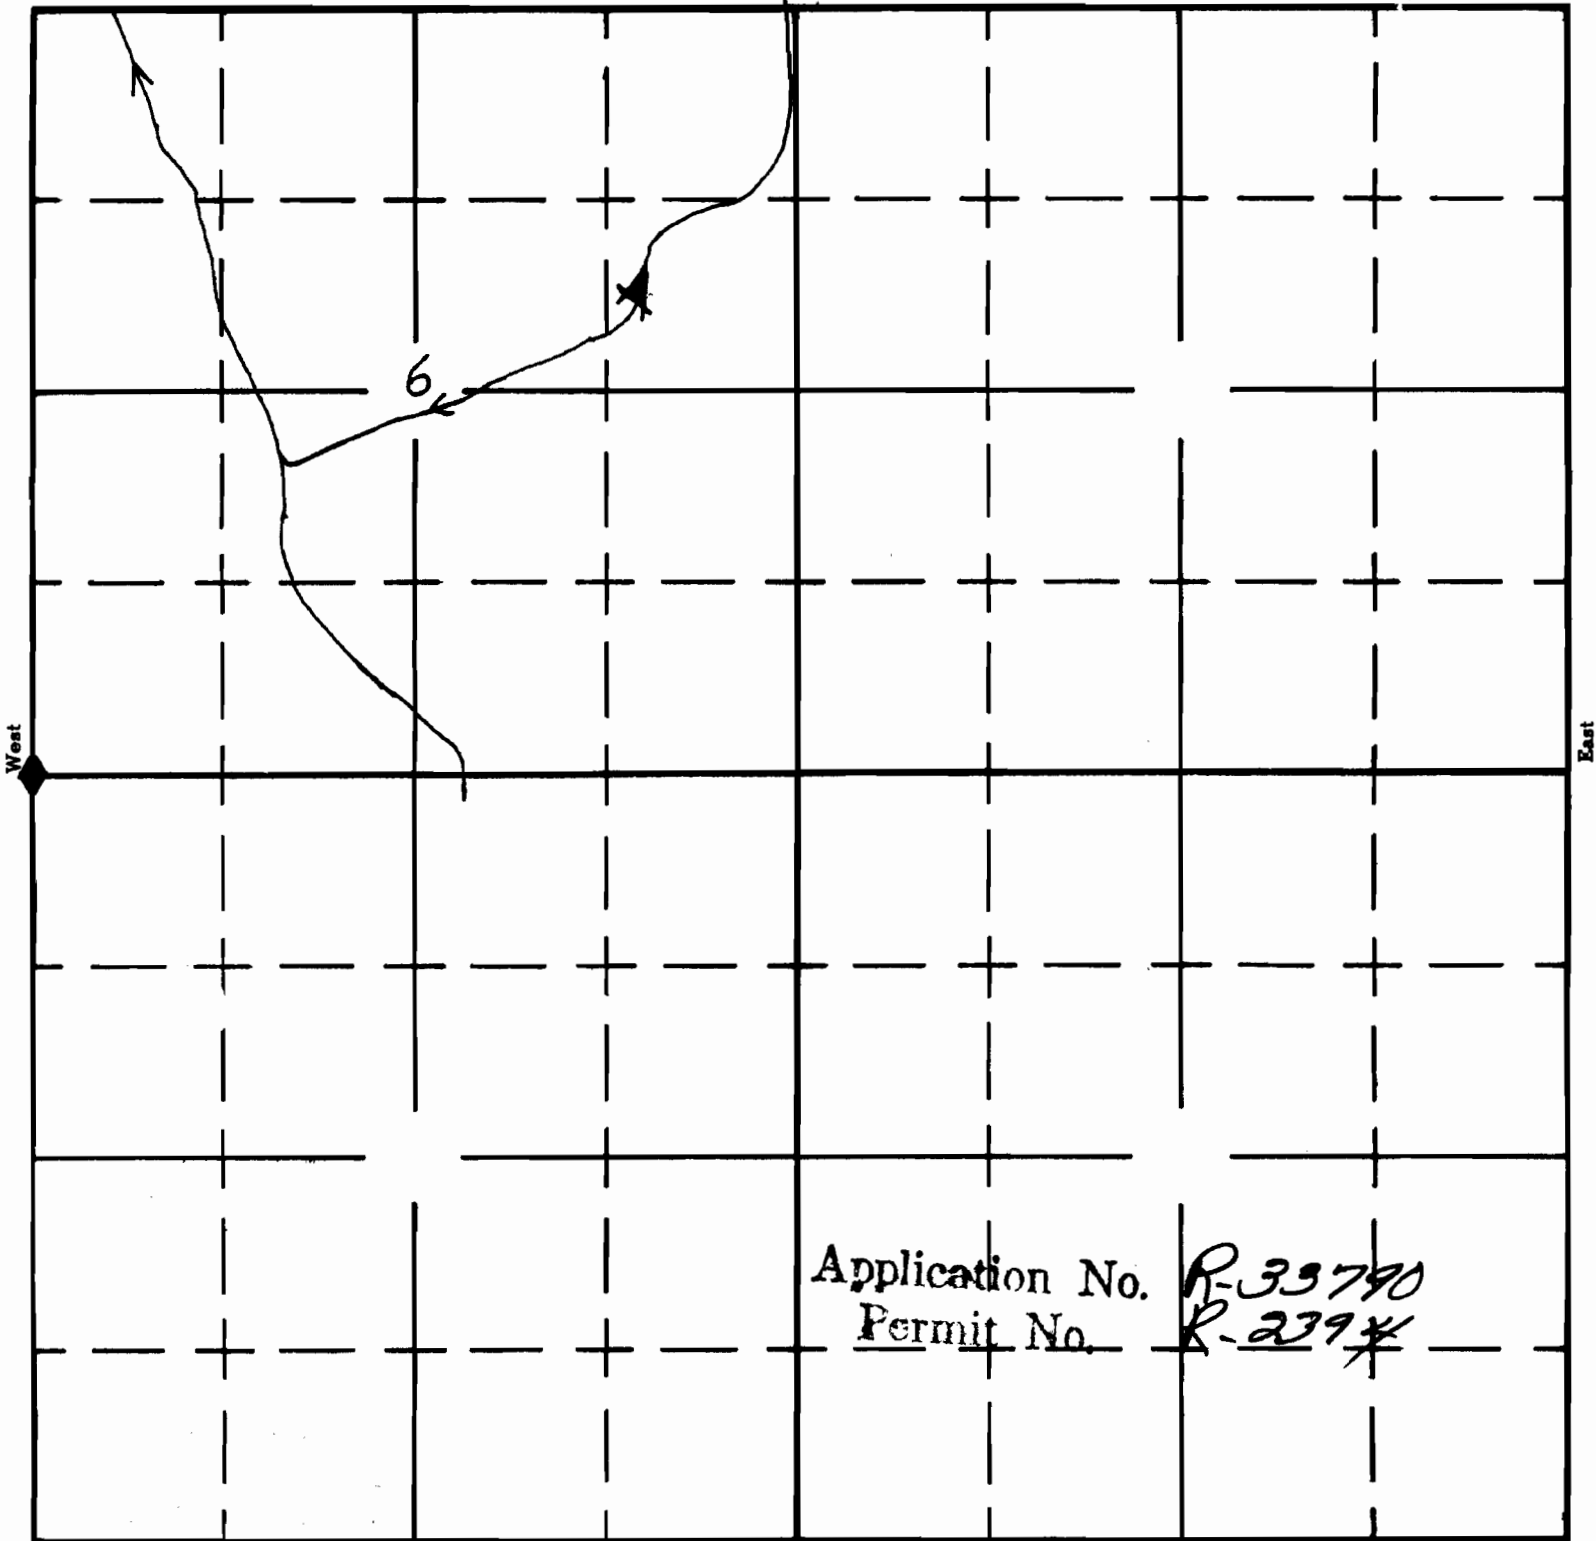

South

PERMIT No.