

UNITED STATES
DEPARTMENT OF THE INTERIOR
BUREAU OF LAND MANAGEMENT


SECTION

Oregon State Water Filings

18

TOWNSHIP 22S., RANGE 30E, W. M. 02-1116

North

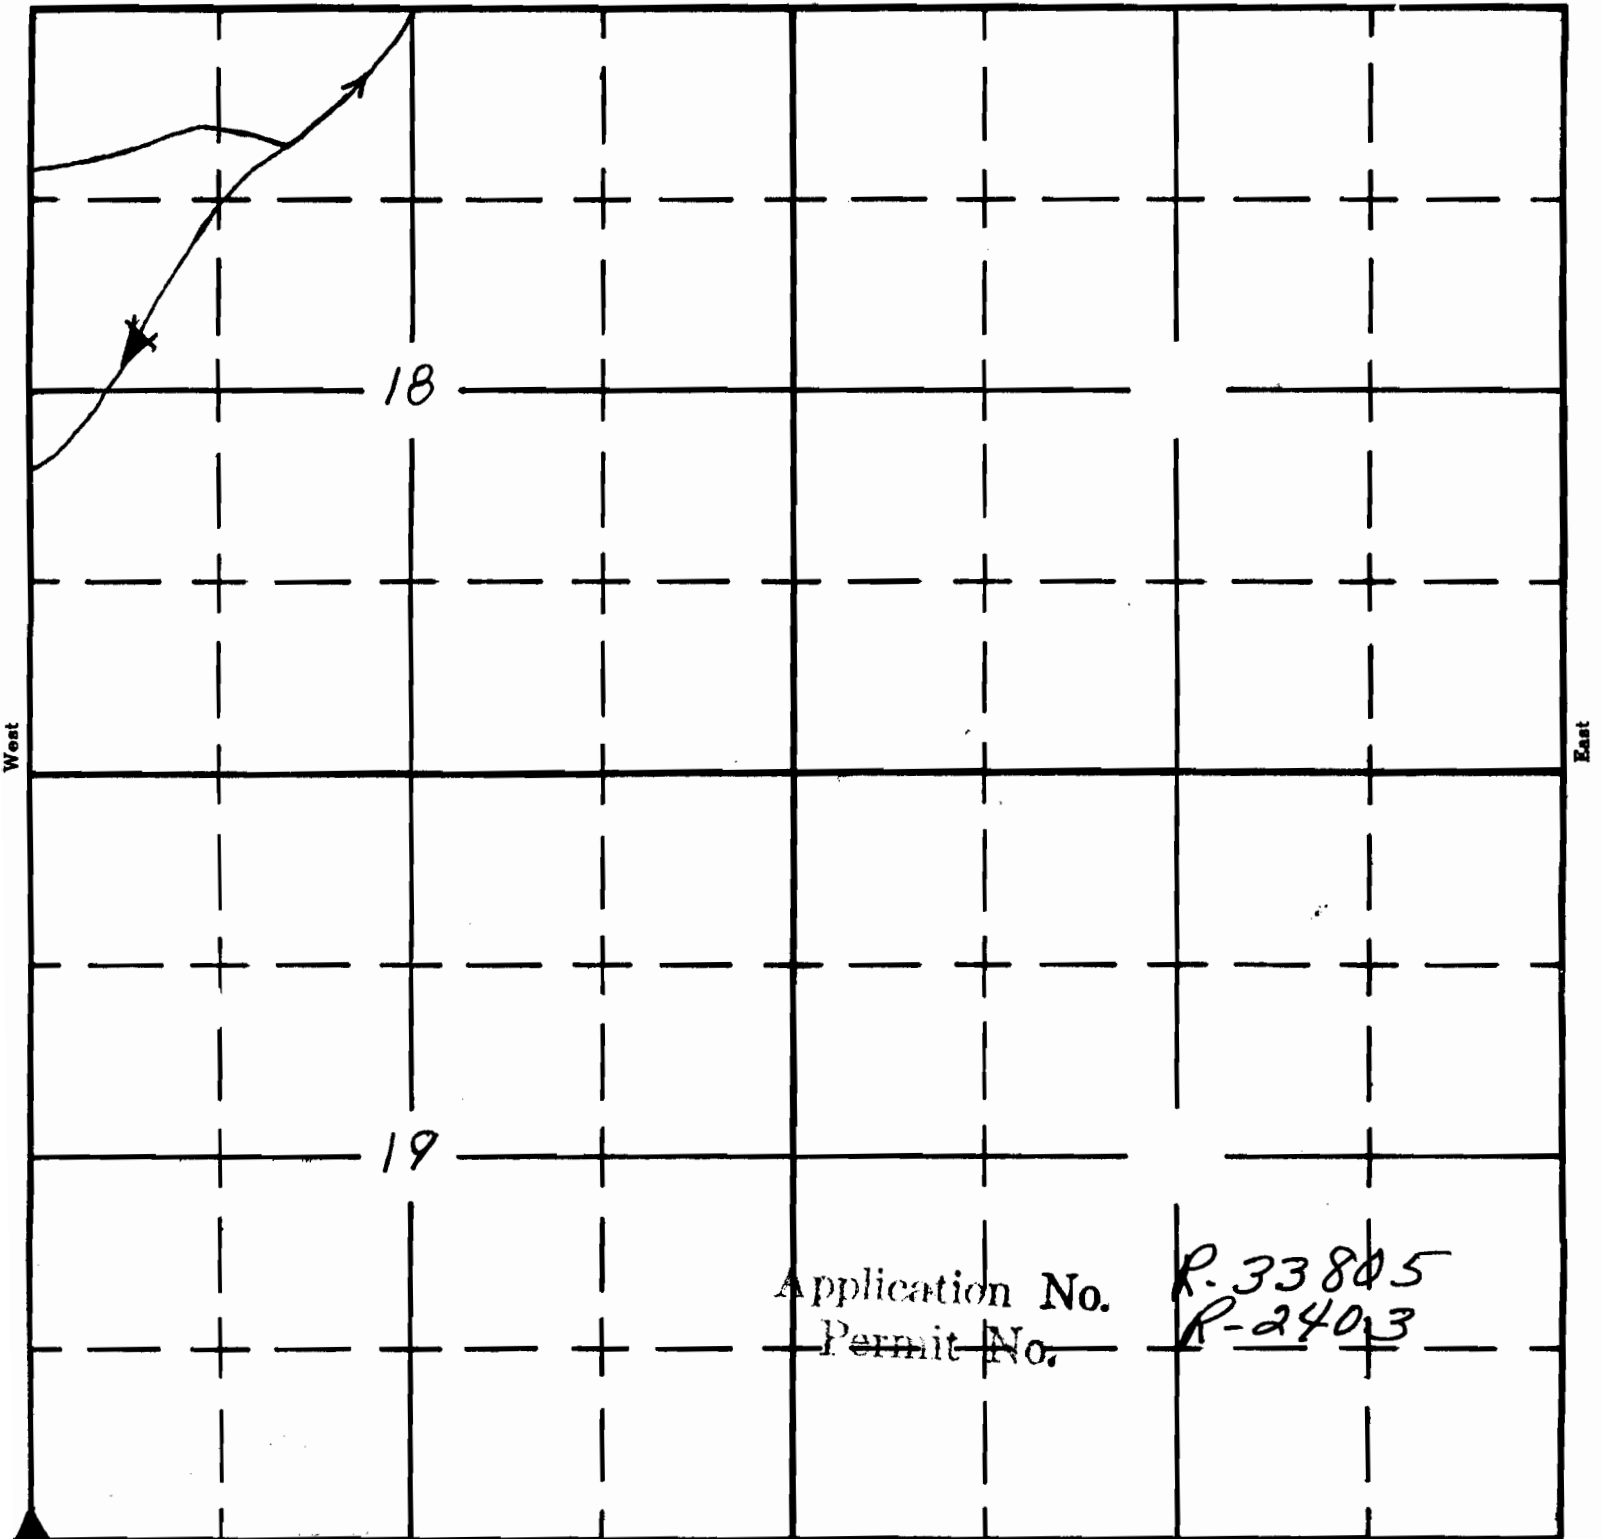

Application No.

Permit No.

R-33805
R-2403

APPLICATION No.

PERMIT No.